



TAX MAP COPY

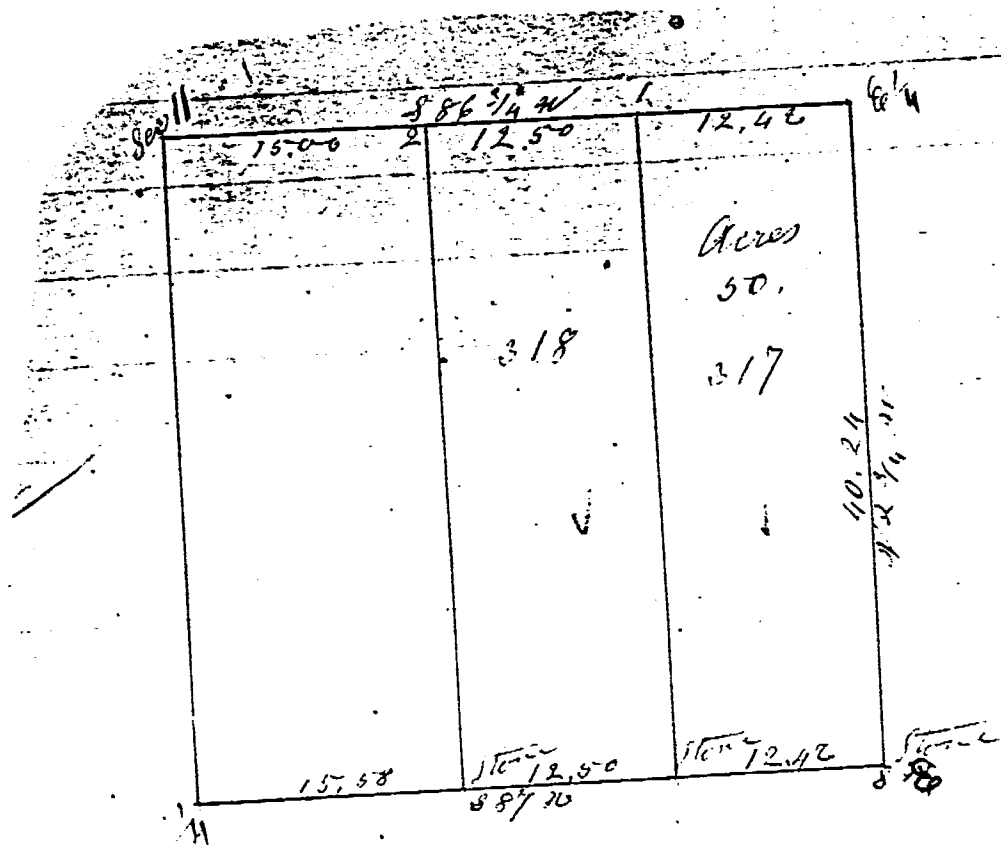

S. E. 1/4 Section 11 T 5 S R 12 E
Surveyed May 30th 1868 for
40 317 L. D. Stark
" 318 Jacob Richard
at E 1/4 Sec 8 N 37 E 15th
Iron. map 5-1189th 11th
at 1. Sec 8 N 36th 9
20 16 N 36 25
Red line 36 N 11 E
" 2. Sec 10 S 58th 12th
Red line 36 N 11 E 25,


MAKING COPY

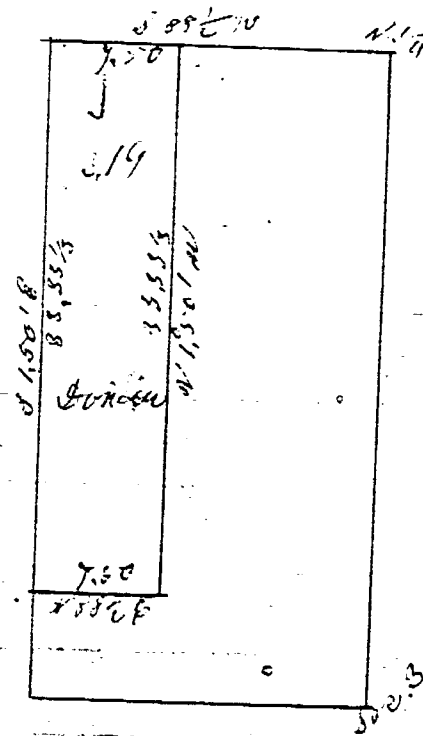

6th N. 1/4, Sect. 3 T. 1 S. R. 14 E.

Surveyed Aug 10th 1868


Source of Little Wilderwood by Arden
of Trolite house.

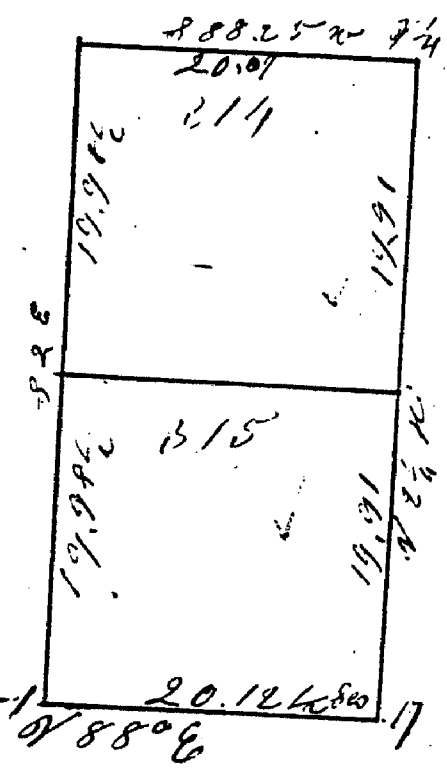

E¹/₂ of NW¹/₄ Sec 17 T 1 S R 15 E Surveyed May 23rd 1868
 for 314 Abraham Van Dundy
 " 315 Harvey Griffith
 at 1, Glen 12 N 2 1/2 links

TAX MAP COPY

TAX MAP COPY

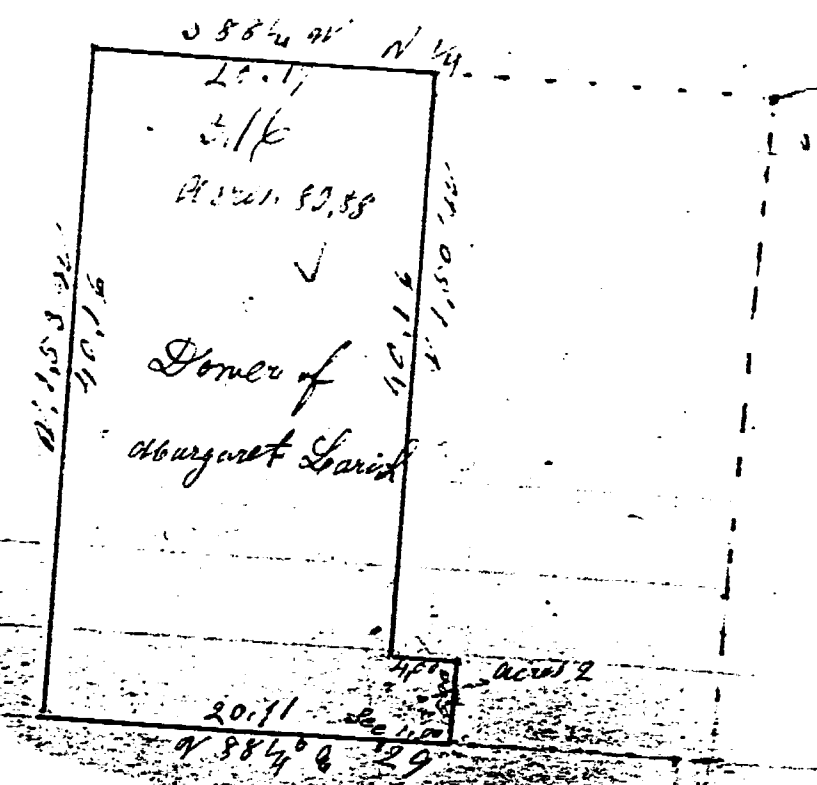

6 1/2 of W 1/4 and pt of N 1/4 of E 1/4 Sec. 24
T 2 S R 15 E Surveyed Aug 23 - 1868
in case of partition of Andrew Larich
against Henry Larich & others