
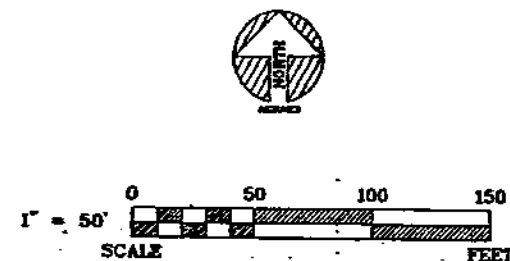


EDEN TOWNSHIP
20-2-15

VOL 6,
PG. 516

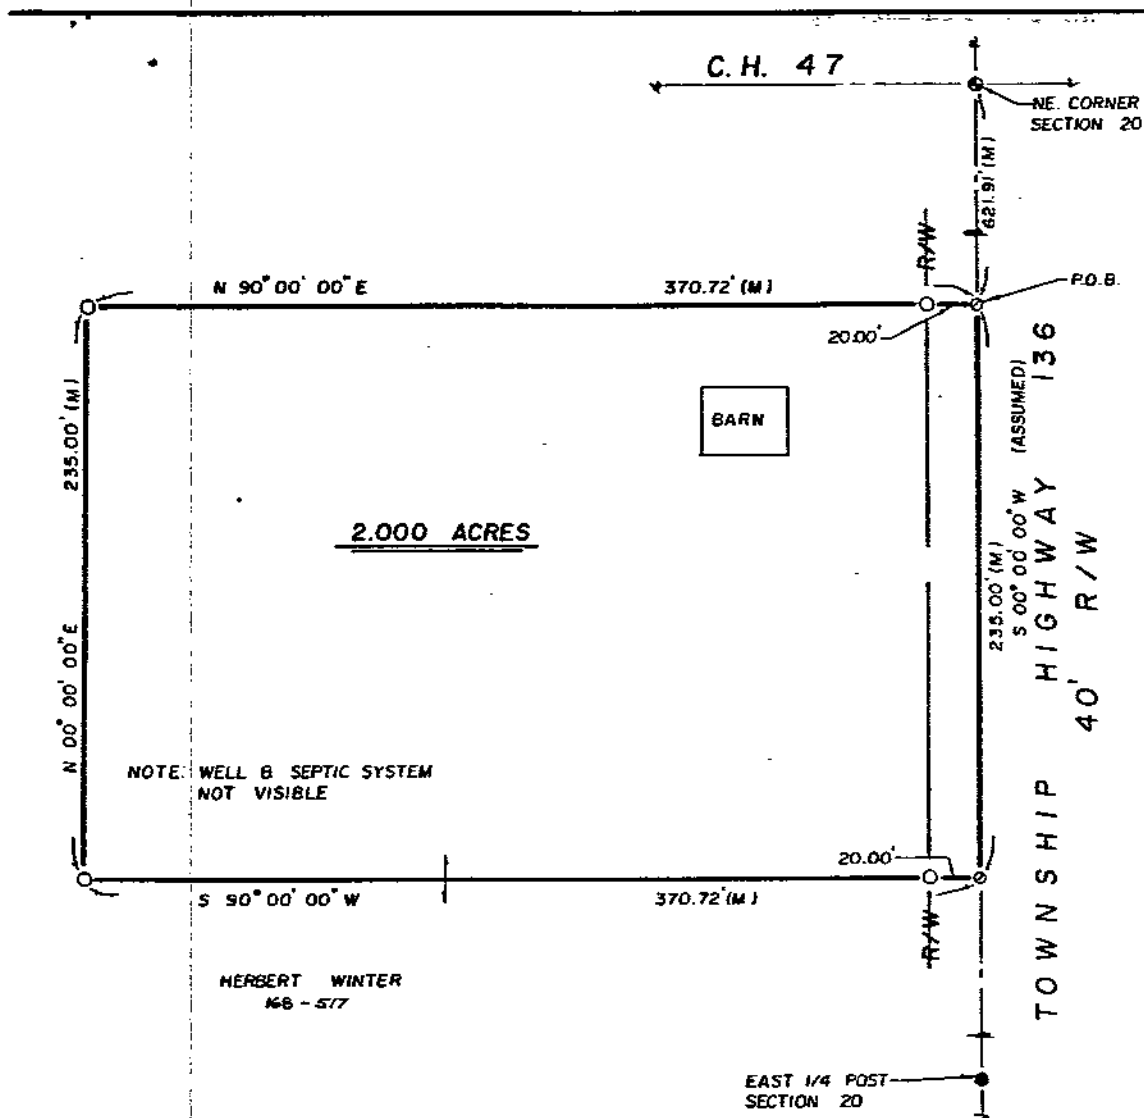

REFERENCES

DEED VOLUME & PAGE AS SHOWN

SURVEY NO. 3574

RECORDED MAY 12 1989

IN SURVEY RECORD VOL 16 PAGE 516

TAX MAP DEPT. WYANDOT CO.

LEGEND

SET	FORM	DESCRIPTION
△	▲	STONE
⊕	⊕	MONUMENT BOX
⊙	⊙	CIRC. MONUMENT
⊗	⊗	RAILROAD SPIKE
⊘	⊘	NAIL
⊙	⊙	IRON ROD
⊙	⊙	IRON PIPE
⊙	⊙	BRELL HOLE
⊙	⊙	WOOD POST
⊙	⊙	DEED
⊙	⊙	PLAT
⊙	⊙	MEASURED
⊙	⊙	SURVEYED
⊙	⊙	CALCULATED

I HEREBY DECLARE THAT THE ABOVE PARCEL WAS
SURVEYED DURING MAY, 1989
PROPERTY LINES SHOWN ARE LIMITED FROM DEEDS
BY RECORD AND ARE ALSO LINES. MEASUREMENTS ARE
MADE FOR ADJACENT MEASUREMENTS. ALL
INFORMATION SHOWN IS TRUE AND CORRECT TO THE
BEST OF MY KNOWLEDGE AND BELIEF.



James G. Herman, Jr.
JAMES G. HERMAN, JR., P.E., REG. SURV.
Original signed in red ink

NOTE: ALL IRON PIPE SET ARE 1/2" DIA. WITH
PERSONALIZED CAPS (J.G.H. #6972).

A.N.K. & ASSOCIATES, INC.

ENGINEERING • SURVEYING • PLANNING
19 SOUTH WASHINGTON STREET, Tiffin, Ohio 44883
19) 448-0908 447-8369 294-2028 531-8345

SURVEY FOR: **HERB WINTER**

LOCATED IN THE NORTHEAST QUARTER OF SECTION 20,
T-2-S, R-15-E, EDEN TOWNSHIP, WYANDOT COUNTY, OHIO

DRAWN BY	CHECKED BY	SHEET NO.
DJN 5-89		1/1
REVISIONS		JOB NO.
		89025-5