
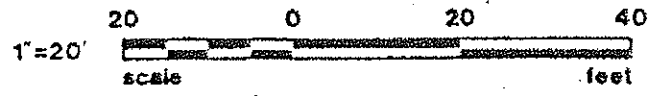


VOL 6 PAGE 506

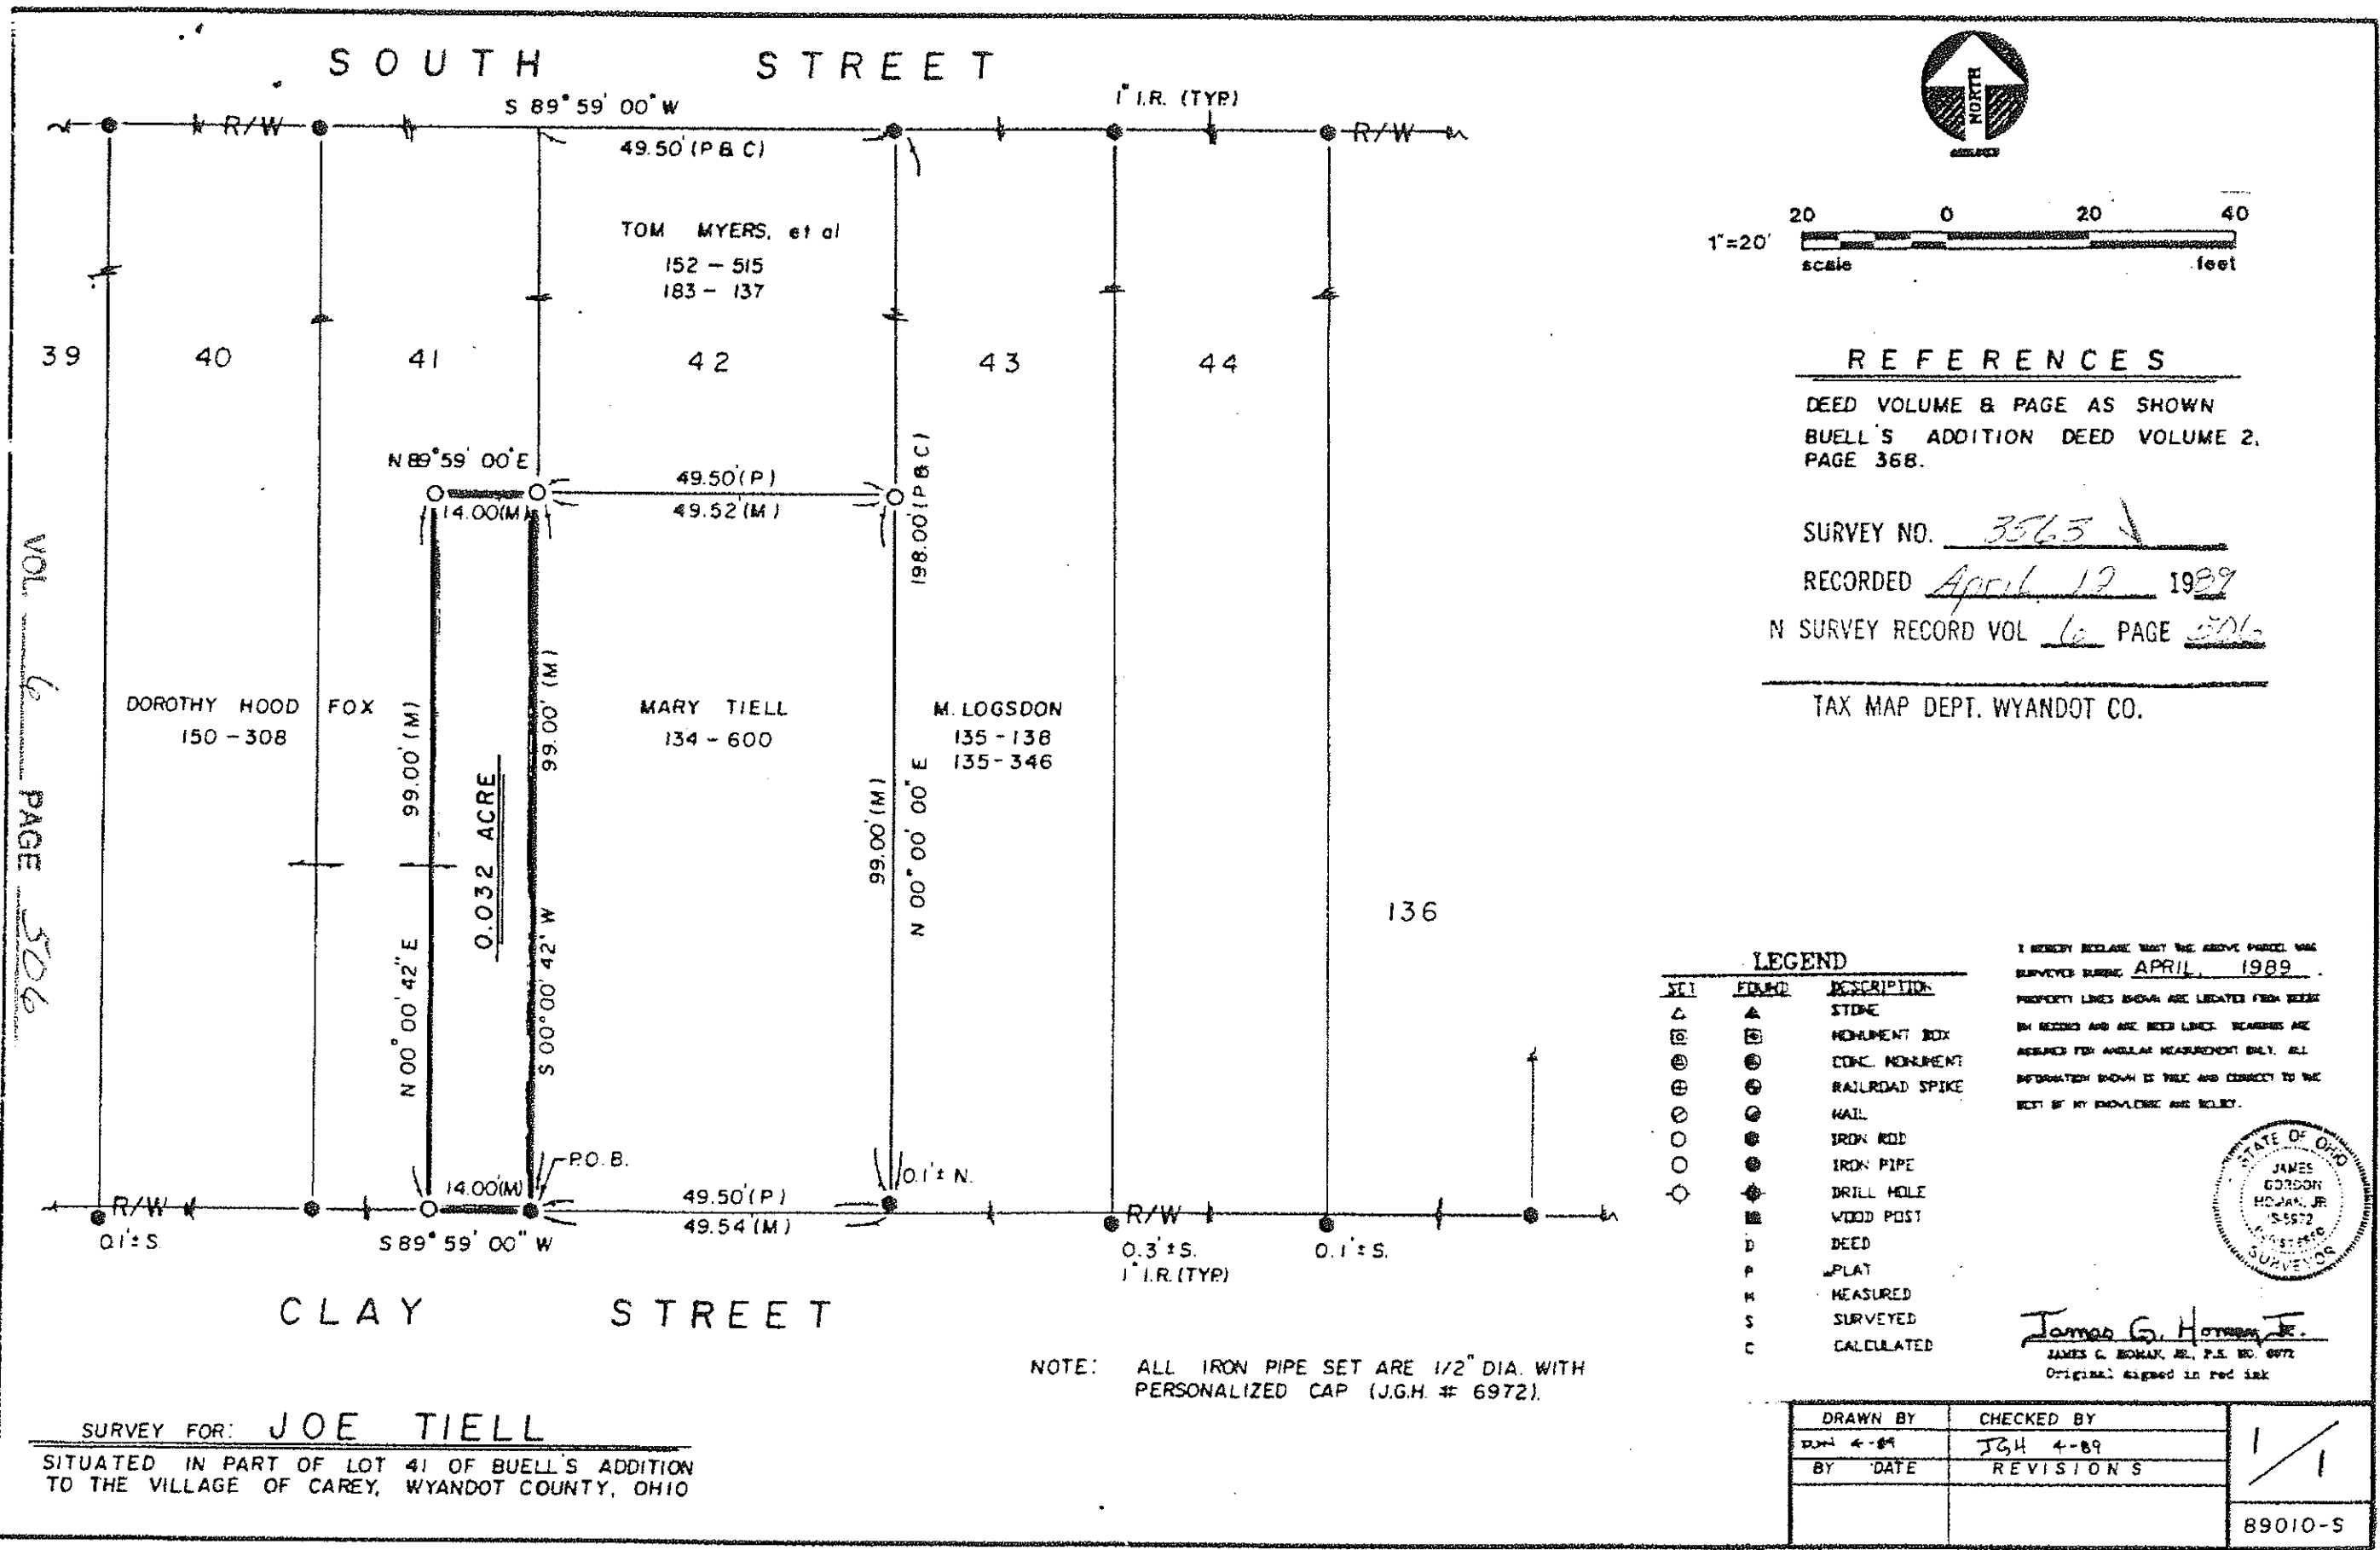

REFERENCES

DEED VOLUME 8 PAGE AS SHOWN
BUELL'S ADDITION DEED VOLUME 2, PAGE 368.

SURVEY NO. 3563

RECORDED April 12 1989

N SURVEY RECORD VOL 6 PAGE 506

TAX MAP DEPT. WYANDOT CO.

SY	FORM	DESCRIPTION
△	△	STONE
⊠	⊠	MONUMENT BOX
⊙	⊙	CONC. MONUMENT
⊕	⊕	RAILROAD SPIKE
○	○	WAIL
○	○	IRON ROD
○	○	IRON PIPE
⊙	⊙	DRILL HOLE
⊞	⊞	WOOD POST
D		DEED
P		PLAT
M		MEASURED
S		SURVEYED
C		CALCULATED

I HEREBY DECLARE THAT THE ABOVE PARCELS WERE SURVEYED DURING APRIL, 1989.

PROPERTY LINES SHOWN ARE LOCATED FROM BEARS IN RECORDS AND ARE BEAR LINES. BEARS ARE ASSUMED FOR ANGULAR MEASUREMENT ONLY. ALL INFORMATION SHOWN IS TRUE AND CORRECT TO THE BEST OF MY KNOWLEDGE AND BELIEF.



James G. Hogan, Jr.
JAMES G. HOGAN, JR., P.E. NO. 15552
Original signed in red ink

NOTE: ALL IRON PIPE SET ARE 1/2" DIA. WITH PERSONALIZED CAP (J.G.H. # 6972).

SURVEY FOR: JOE TIELL

SITUATED IN PART OF LOT 41 OF BUELL'S ADDITION TO THE VILLAGE OF CAREY, WYANDOT COUNTY, OHIO

DRAWN BY	CHECKED BY	1/1
DWH 4-89	JGH 4-89	
BY DATE	REVISIONS	
		89010-S