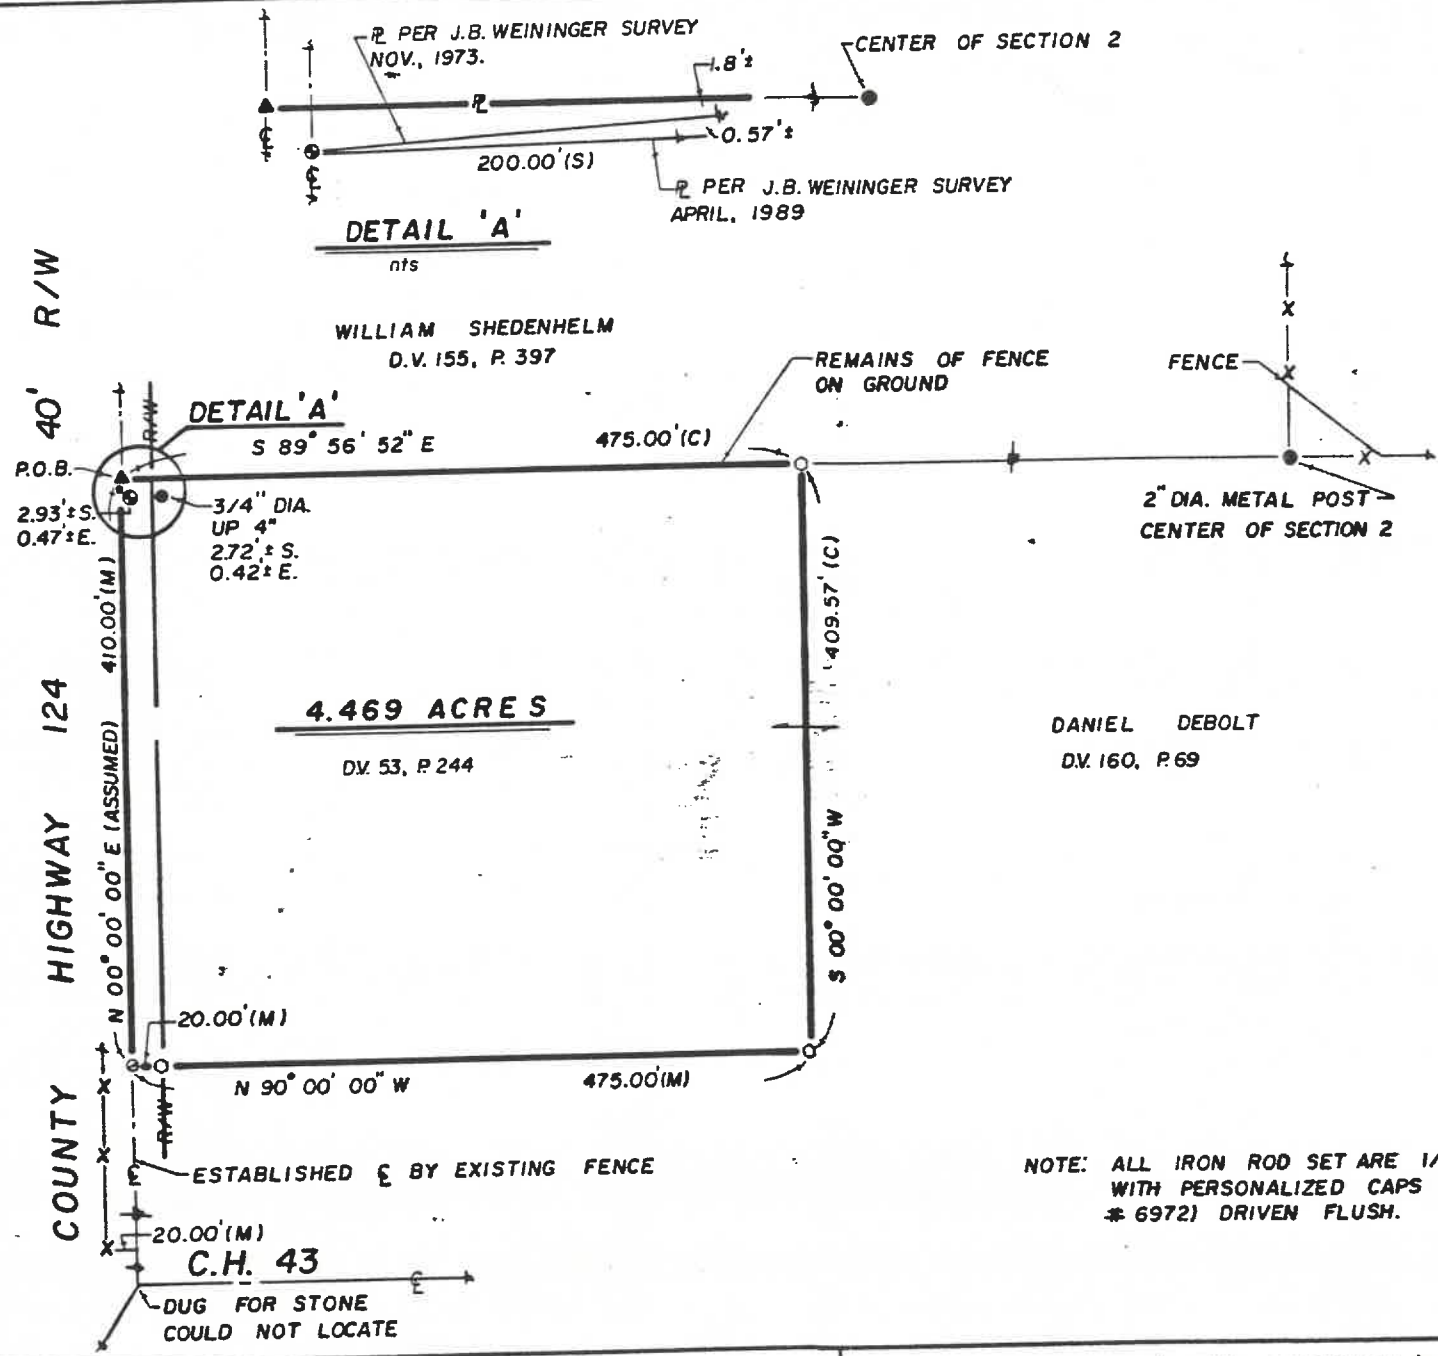


REFERENCES

DEED VOLUME 8 PAGE AS SHOWN
SURVEY VOL. 3, P. 244
SURVEY FOR W. SHEDENHELM BY
J.B. WEININGER, NOV. 1973 & APRIL, 1989

SURVEY NO. 3601 ✓
RECORDED July 18 1989
IN SURVEY RECORD VOL. 6 PAGE 536
TAX MAP DEPT. WYANDOT CO.

SET	FOUND	DESCRIPTION
▲	▲	STONE
■	■	MONUMENT BOX
●	●	CONC. MONUMENT
⊙	⊙	RAILROAD SPIKE
○	○	NAIL
●	●	IRON ROD
●	●	IRON PIPE
⊙	⊙	DRILL HOLE
■	■	WOOD POST
D		DEED
P		PLAT
M		MEASURED
S		SURVEYED
C		CALCULATED

I HEREBY DECLARE THAT THE ABOVE PARCEL WAS
SURVEYED DURING JULY, 1989.
PROPERTY LINES SHOWN ARE LOCATED FROM DEEDS
ON RECORD AND ARE BEING LOCATED. BEARINGS ARE "P"
ASSUMED FOR ANIMALS MEASUREMENT ONLY. ALL
INFORMATION SHOWN IS TRUE AND CORRECT TO THE
BEST OF MY KNOWLEDGE AND BELIEF.



James G. Homan, Jr.
JAMES G. HOMAN, JR., P.E. REG. 8972
Original signed in red ink

NOTE: ALL IRON ROD SET ARE 1/2" DIA.
WITH PERSONALIZED CAPS (J.G.H.
6972) DRIVEN FLUSH.

H.A.N.K. & ASSOCIATES, INC.
ENGINEERING • SURVEYING • PLANNING
48 SOUTH WASHINGTON STREET, TIFFIN, OHIO 44883
(419) 447-4300

SURVEY FOR: DAN DEBOLT
LOCATED IN THE SW. 1/4 OF SECTION 2,
CRANE TOWNSHIP T-2-S, R-14-E,
WYANDOT COUNTY, OHIO

DRAWN BY:	CHECKED BY:	SHEET NO.
DJN 7-10-89	JGH 7-11-89	1
REVISIONS		JOB NO.
		89038-S

VOL. 6 PAGE 536