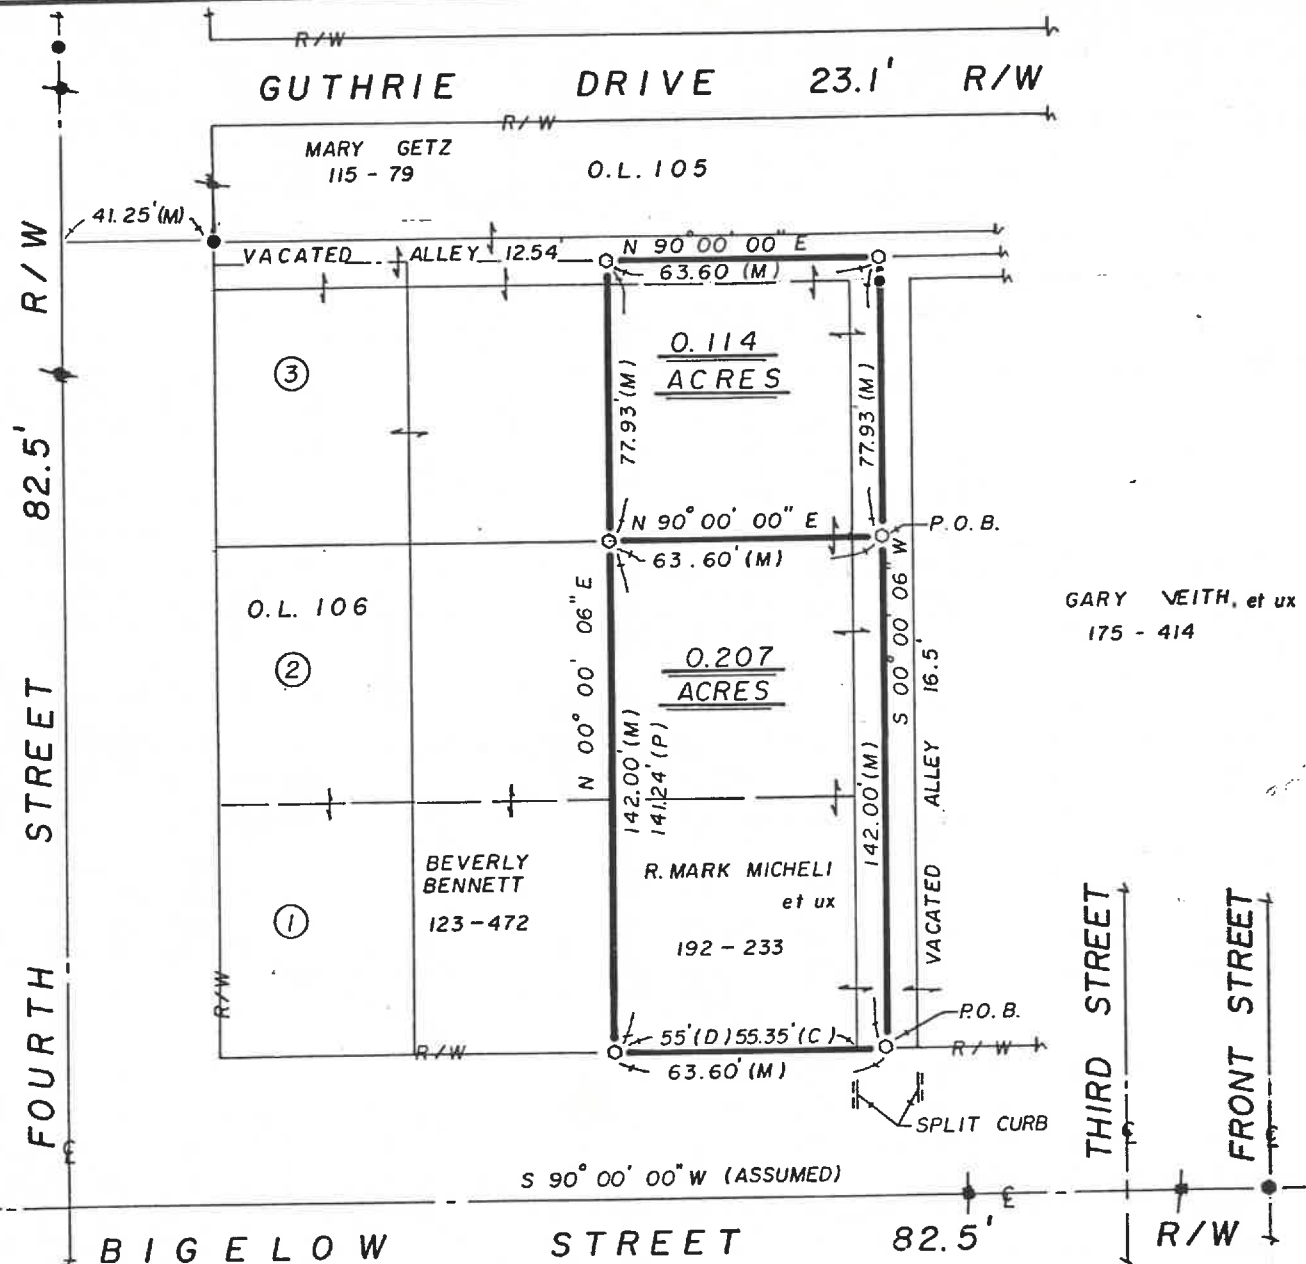


REFERENCES

DEED VOLUME & PAGE AS SHOWN
 SURVEY NO. 843, 1112
 SURVEY FOR D. GOTTFRIED BY C. ROLLINS, JR.
 DATED SEPT. 21, 1976
 PLAT VOLUME & PAGE:

SURVEY NO. 7622 V.I., P. 40
 VOL 6 PAGE 552 V.I., P. 5
 DATE Oct 19, 1989

NOTE: ALL IRON ROD SET ARE 1/2" DIA. WITH
 PERSONALIZED CAPS (J.G.H. # 6972)
 DRIVEN FLUSH.

LEGEND.

SET	FOUND	DESCRIPTION
▲	▲	STONE
◻	◻	MONUMENT BOX
⊗	⊗	CONC. MONUMENT
⊙	⊙	RAILROAD SPIKE
●	●	NAIL
○	○	IRON ROD
⊕	⊕	IRON PIPE
⊖	⊖	DRILL HOLE
⊗	⊗	WOOD POST
⊙	⊙	DEED
⊕	⊕	PLAT
⊖	⊖	MEASURED
⊗	⊗	SURVEYED
⊙	⊙	CALCULATED

I HEREBY DECLARE THAT THE ABOVE PARCEL
 WAS SURVEYED DURING OCT., 1989
 PROPERTY LINES SHOWN ARE LOCATED FROM
 DEEDS ON RECORD AND ARE DEED LINES.
 BEARINGS ARE ASSUMED FOR ANGULAR MEASUREMENT ONLY. ALL INFORMATION SHOWN IS
 TRUE AND CORRECT TO THE BEST OF MY
 KNOWLEDGE AND BELIEF.



James G. Homan, Jr. 10-19-89
 JAMES G. HOMAN, JR., P.S. #6972 DATE
 ORIGINAL SIGNED IN RED INK

HANK AND ASSOCIATES, INC.

ENGINEERING • SURVEYING
 49 SOUTH WASHINGTON STREET, TIFFIN, OHIO 44883
 419-447-4300

SURVEY FOR: SANDY MICHELI

BEING PART OF LOTS 1, 2 & 3 OF WOLFORD'S SUBDIV.
 OF OUTLOT 106 IN THE CITY OF UPPER SANDUSKY,
 WYANDOT COUNTY, OHIO

DRAWN BY:	CHECKED BY:	SHEET NO.
djn 10-19-89	JGH 10-19-89	1/1
REVISIONS		JOB NO.
		89087-S