
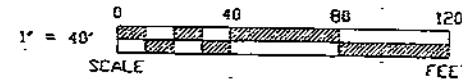


SALEM
18-2-13

TAX MAP COPY

VOL 6
PG. 563

ROBERT WALTER
190 - 831

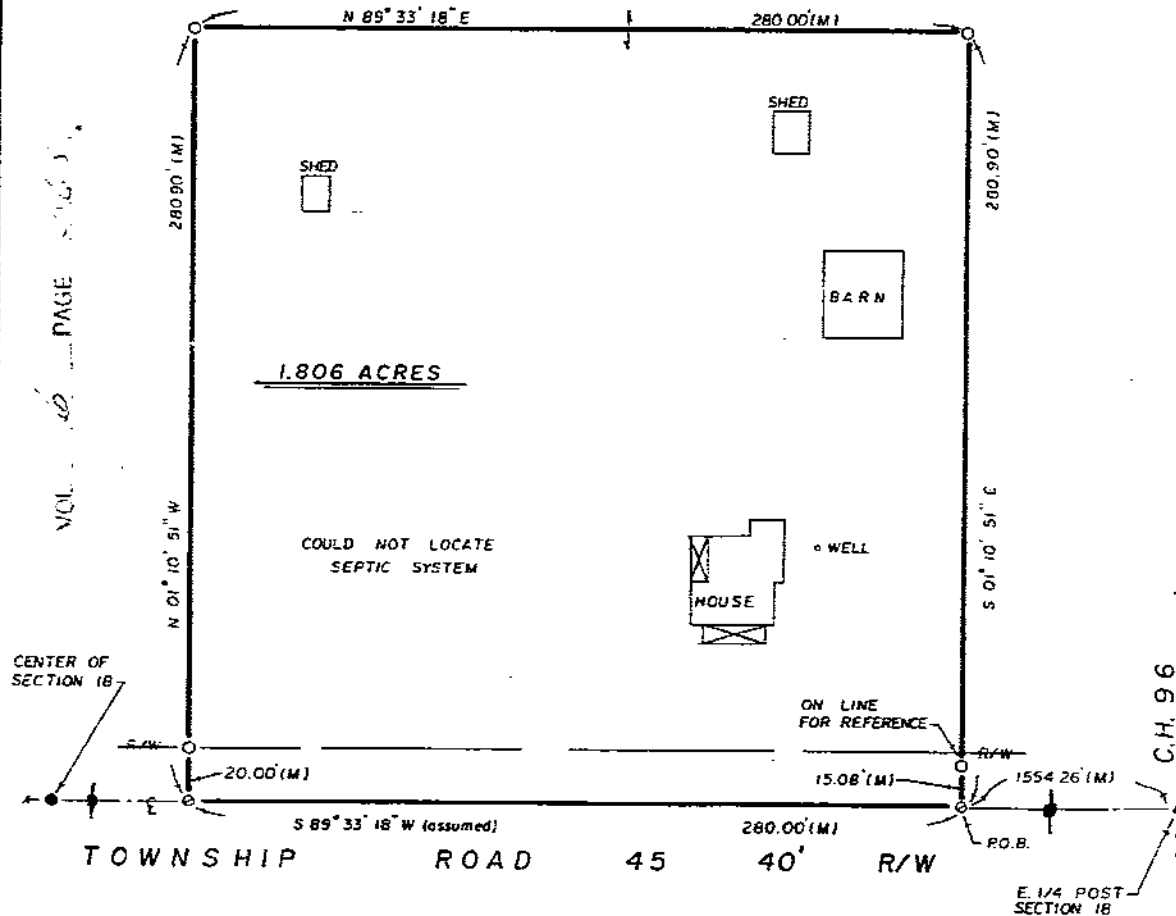

REFERENCES

DEED VOLUME & PAGE AS SHOWN
WYANDOT COUNTY CORNERSTONE REFERENCES

SURVEY NO. 3637
VOL. 6 PG. 563
DATE JAN 2, 1990

NOTE: ALL IRON ROD SET ARE 1/2" DIA. WITH
PERSONALIZED CAPS (J.G.H. # 6972)
DRIVEN FLUSH.

LEGEND

SET	FOUND	DESCRIPTION
△	▲	STONE
□	■	MONUMENT BOX
○	●	CONC. MONUMENT
⊙	⦿	RAILROAD SPIKE
○	●	NAIL
○	●	IRON ROD
○	●	IRON PIPE
○	●	DRILL HOLE
○	●	WOOD POST
○	●	DEED
○	●	PLAT
○	●	MEASURED
○	●	SURVEYED
○	●	CALCULATED

I HEREBY DECLARE THAT THE ABOVE PARCEL
WAS SURVEYED DURING DEC. 1989
PROPERTY LINES SHOWN ARE LOCATED FROM
DEEDS ON RECORD AND ARE DEED LINES
BEARINGS ARE ASSUMED FOR ANGULAR MEASUREMENT
ONLY ALL INFORMATION SHOWN IS
TRUE AND CORRECT TO THE BEST OF MY
KNOWLEDGE AND BELIEF



James C. Homan, Jr.
JAMES C. HOMAN, JR., P.S. #6972 DATE
ORIGINAL SIGNED IN RED INK

HANK AND ASSOCIATES, INC.

ENGINEERING • SURVEYING
49 SOUTH WASHINGTON STREET, TIFFIN, OHIO 44883
419-447-4300

SURVEY FOR: **ROBERT WALTER**

LOCATED IN THE NE 1/4 OF SECTION 18,
SALEM TOWNSHIP, T-2-S, R-13-E,
WYANDOT COUNTY, OHIO

DRAWN BY: CHECKED BY: SHEET NO.

djn 12-20-89 JCH 12-21-89 1

REVISIONS JOB NO.

89110-S