


TAX MAP COPY

VOL. 6 PAGE 579 CHIEF ST. (R/W - 23.00')

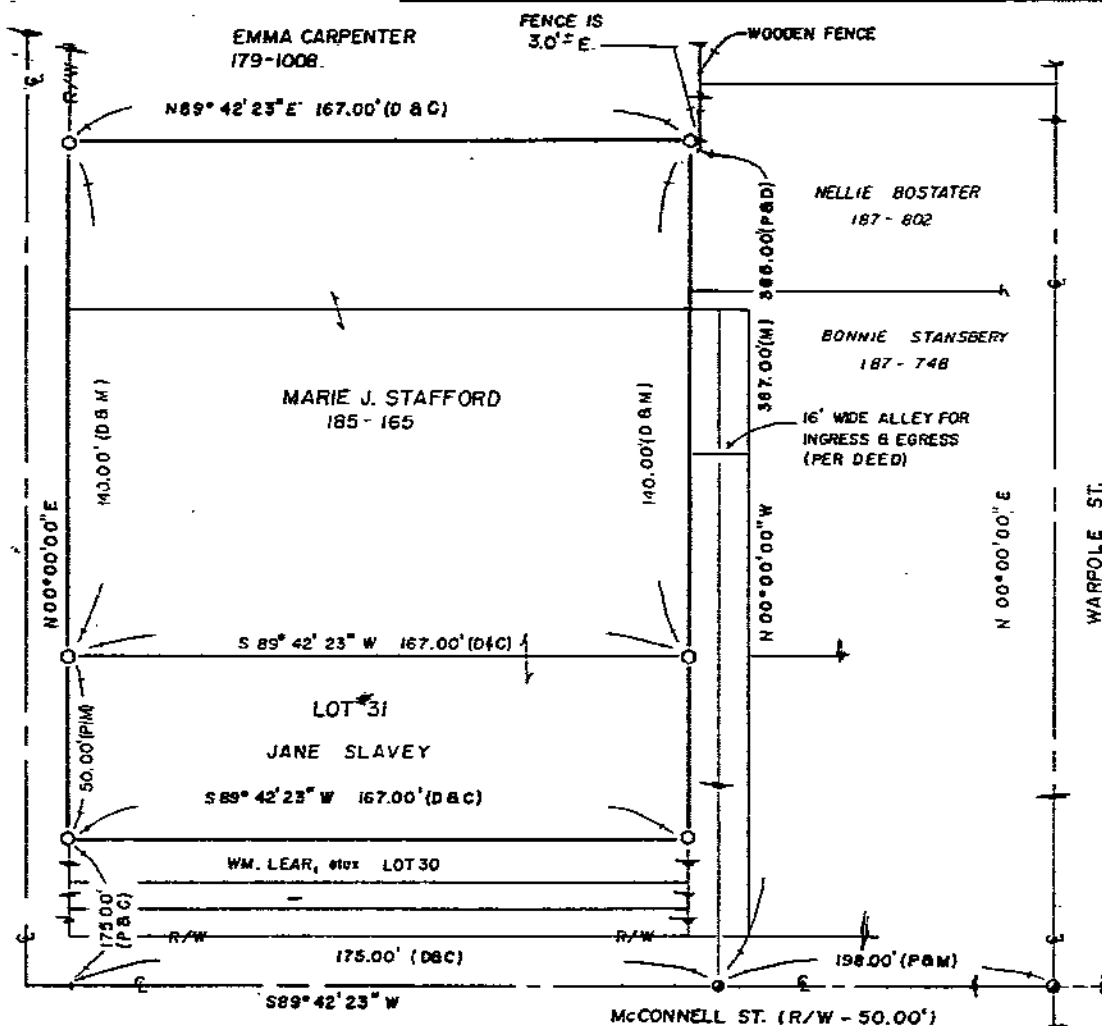

1"=30'  scale feet

DEED VOLUME & PAGE AS SHOWN
WYANDOT COUNTY CORNERSTONE REFERENCES

NOTE: ALL IRON ROD SET ARE 1/2" DIA. WITH
PERSONALIZED CAPS (J.G.H * 6972)
DRIVEN FLUSH.

SURVEY NO. 3256
VOL 6 PAGE 579
DATE MAR 22 1990

LEGEND

SET	FOUNDED	DESCRIPTION
		STONE
		MONUMENT BOX
		CONC. MONUMENT
		RAILROAD SPIKE
		NAIL
		IRON ROD
		IRON PIPE
		DRILL HOLE
		WOOD POST
D		DEED
P		PLAT
M		MEASURED
S		SURVEYED
C		CALCULATED

I HEREBY DECLARE THAT THE ABOVE PARCEL
WAS SURVEYED DURING NOV 1989
PROPERTY LINES SHOWN ARE LOCATED FROM
DEEDS ON RECORD AND ARE DEED LINES.
BEARINGS ARE ASSUMED FOR ANGULAR MEASUREMENT ONLY ALL INFORMATION SHOWN IS
TRUE AND CORRECT TO THE BEST OF MY
KNOWLEDGE AND BELIEF



James G. Homan, Jr. R. 11-21-9
JAMES G. HOMAN, JR., P.S. #8372 DATE
ORIGINAL SIGNED IN RED INK

SURVEY FOR: MARIE J. STAFFORD

ENGINEERING • SURVEYING
49 SOUTH WASHINGTON STREET, TIFFIN, OHIO 44883
419-447-4300

BEING PART OF LOT #8 & LOT #9 OF CY. PIERSON'S
ADDITION TO UPPER SANDUSKY, WYANDOT COUNTY, OH.

DRAWN BY:	CHECKED BY:	SHEET NO:
fts 11-21-89		1
REVISIONS		JOB NO
1. 3-6-90 Remove Answer For Pump In. 7/7/89		89097-S