



ARLENE M. HENKLE
175 - 628
VOL. 6
PAGE 588

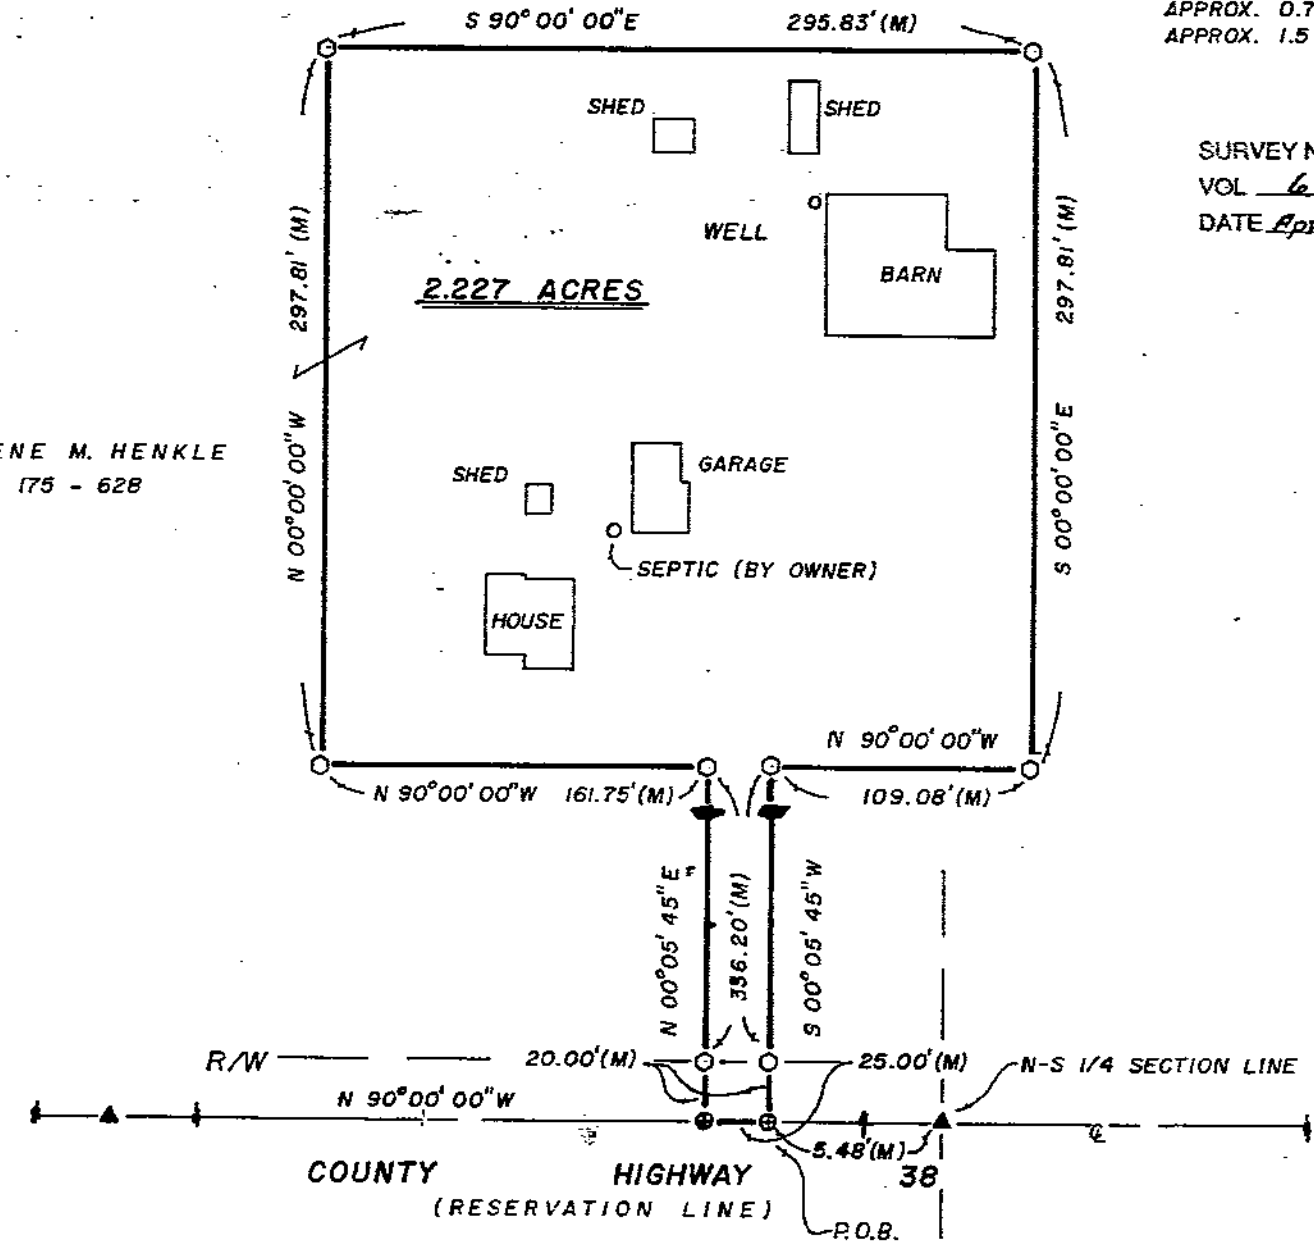

ACREAGE SUMMARY:
APPROX. 0.7 ACRES IN NE 1/4
APPROX. 1.5 ACRES IN NW 1/4

SURVEY NO. 3245
VOL. 6, PAGE 588
DATE April, 26, 1990

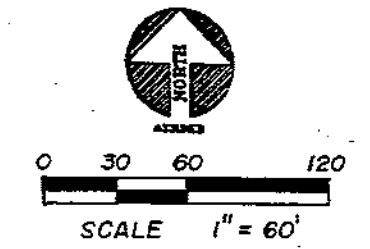

REFERENCES

DEED VOLUME AND PAGE AS SHOWN
DEED: 175 - 628
SURVEY VOL. 3, PAGE 203

NOTE: ALL IRON ROD SET ARE 1/2" DIAMETER WITH PERSONALIZED CAPS (J.G.H. #6972) DRIVEN FLUSH.

LEGEND		
SET	FOUND	DESCRIPTION
△	▲	STONE
⊠	⊠	MONUMENT BOX
⊙	⊙	CONC. MONUMENT
⊕	⊕	RAILROAD SPIKE
○	○	NAIL
●	●	IRON ROD
●	●	IRON PIPE
●	●	DRILL HOLE
■	■	WOOD POST
D		DEED
P		PLAT
M		MEASURED
S		SURVEYED
C		CALCULATED

I HEREBY DECLARE THAT THE ABOVE PARCEL WAS SURVEYED DURING APRIL 1990. PROPERTY LINES SHOWN ARE LOCATED FROM DEEDS ON RECORD AND ARE DEED LINES. BEARINGS ARE ASSUMED FOR ANGULAR MEASUREMENT ONLY. ALL INFORMATION SHOWN IS TRUE AND CORRECT TO THE BEST OF MY KNOWLEDGE AND BELIEF.



James G. Homan, Jr. 4-25-90
JAMES G. HOMAN, JR., P.S. #6972 DATE
ORIGINAL SIGNED IN RED INK

HANK AND ASSOCIATES, INC.
ENGINEERING • SURVEYING
49 SOUTH WASHINGTON STREET, TIFFIN, OHIO 44883
419-447-4300

SURVEY FOR: **WILLIAM GILLEN**
LOCATED IN THE NE 1/4 & NW 1/4 OF SECTION 31,
TYMOCHTEE TOWNSHIP, T-1-S, R-14-E,
WYANDOT COUNTY, OHIO

DRAWN BY:	CHECKED BY:	SHEET NO.
VBK 4-90	JGH 4-25-90	1
REVISIONS		JOB NO.
		90037 - S