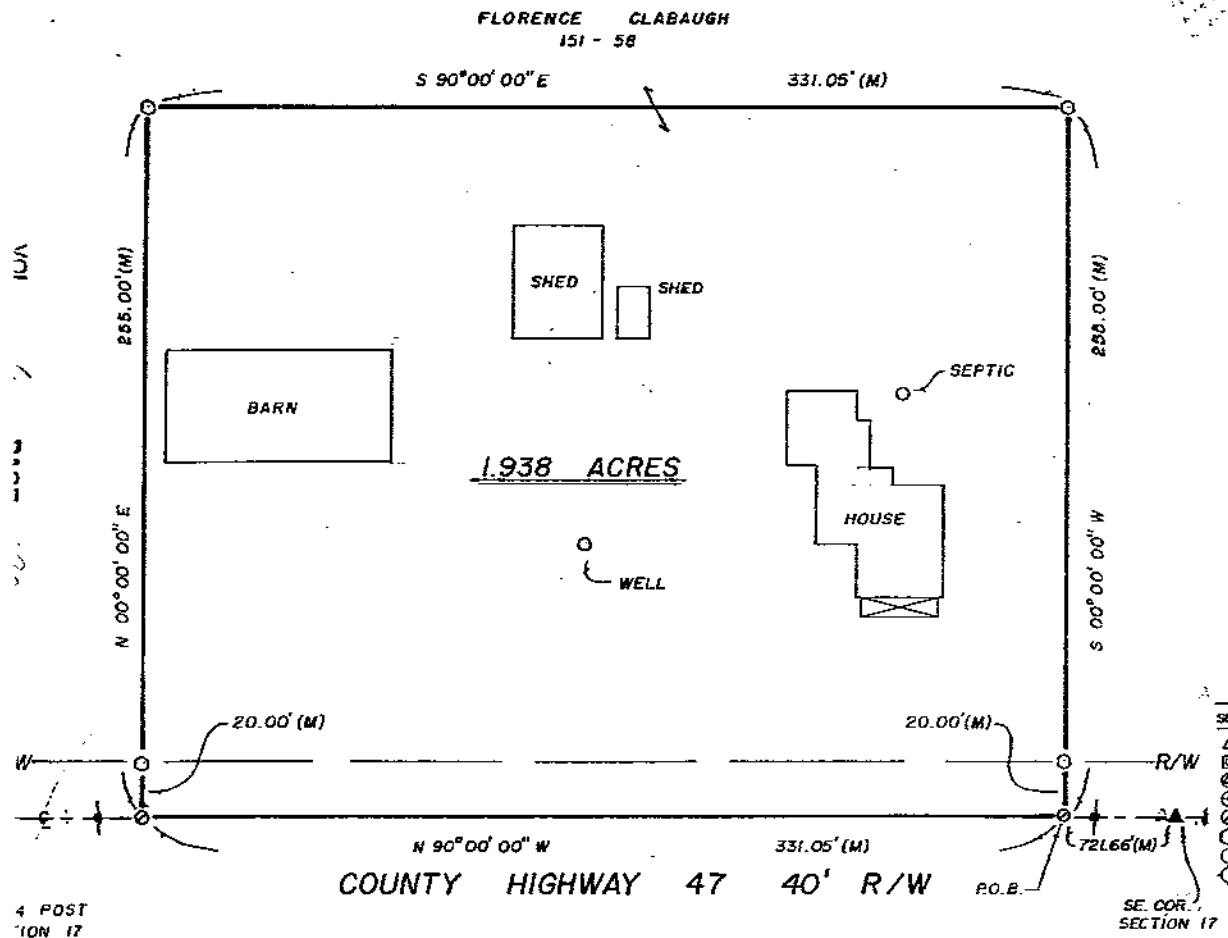


REFERENCES

SURVEY NO. 3267VOL. 6 PAGE 590DATE May 16, 1990

DEED VOLUME AND PAGE AS SHOWN.
WYANDOT COUNTY CORNERSTONE
REFERENCES.

NOTE: ALL IRON ROD SET ARE 1/2"
DIAMETER WITH PERSONALIZED CAPS
(J.G.H. #6972) DRIVEN FLUSH.

LEGEND

SET	FOUND	DESCRIPTION
▲	▲	STONE
■	■	MONUMENT BOX
⊙	⊙	CONC. MONUMENT
⊕	⊕	RAILROAD SPIKE
●	●	NAIL
●	●	IRON ROD
●	●	IRON PIPE
●	●	DRILL HOLE
●	●	WOOD POST
D		DEED
P		PLAT
M		MEASURED
S		SURVEYED
C		CALCULATED

I HEREBY DECLARE THAT THE ABOVE PARCEL
WAS SURVEYED DURING APRIL 1990
PROPERTY LINES SHOWN ARE LOCATED FROM
DEEDS ON RECORD AND ARE DEED LINES
BEARINGS ARE ASSUMED FOR ANGULAR MEASUREMENT
ONLY. ALL INFORMATION SHOWN IS
TRUE AND CORRECT TO THE BEST OF MY
KNOWLEDGE AND BELIEF.



James G. Homan, Jr.
JAMES G. HOMAN, JR., P.S. 6972 DATE
ORIGINAL SIGNED IN RED INK

HANK AND ASSOCIATES, INC.

ENGINEERING • SURVEYING
3 SOUTH WASHINGTON STREET, TIFFIN, OHIO 44883
419-447-4300

SURVEY FOR: JIM CLABAUGH

LOCATED IN THE SE 1/4 OF SECTION 17,
CRANE TOWNSHIP, T-2-S, R-14-E
WYANDOT COUNTY, OH.

DRAWN BY:	CHECKED BY:	SHEET NO.
VBK	4/90	1/1
REVISIONS		JOB NO.
		90038-S