


VOL 6
PG. 617

COUNTY HIGHWAY 109 33' R/W

ARTHUR GUTTFREED
125 - 639

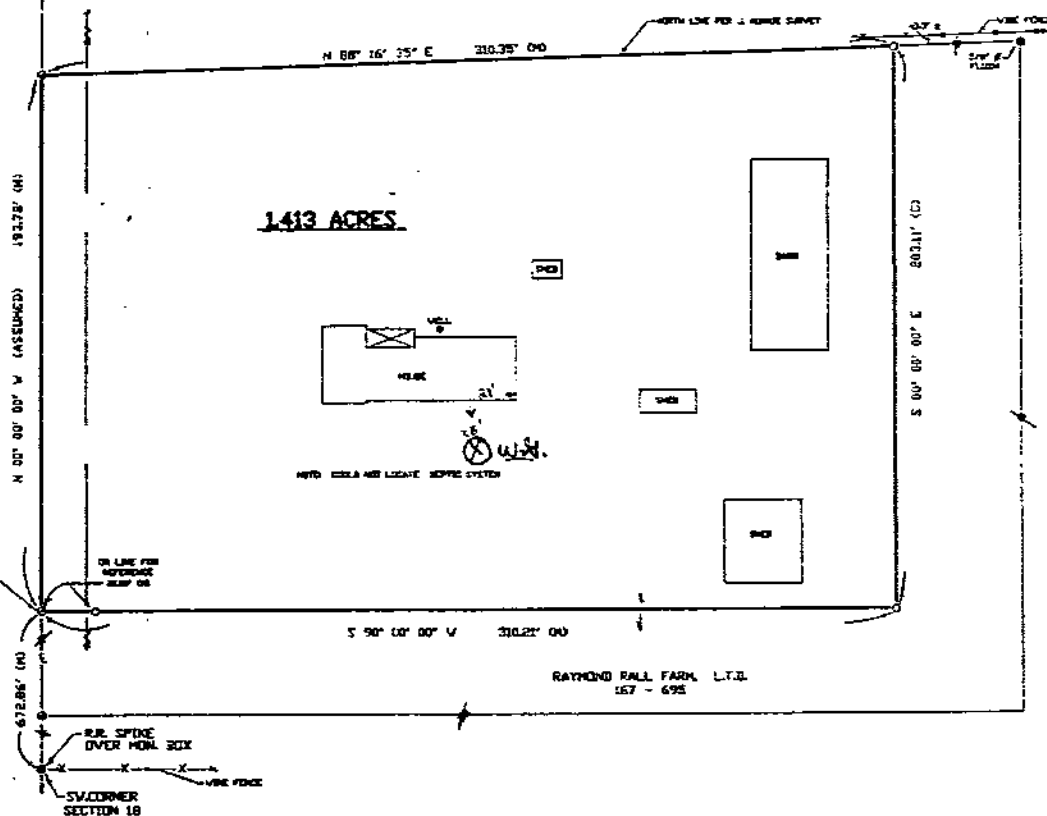

1" = 40'

40 0 40 80

SCALE FEET

DEED VOLUME & PAGE AS SHOWN

SURVEY FOR R. RALL BY J. MORRIS, APRIL 1984

NOTE: ALL IRON ROD SET ARE 1/2" DIA. WITH
PERSONALIZED CAPS (HANK # 6972)
DRIVEN FLUSH.

X SEPTIC TANK LOCATION
By WILLIAM T. GILLEN

SET	FOUND	DESCRIPTION
		STONE
		MONUMENT BOX
		CONC. MONUMENT
		RAILROAD SPIKE
		NAIL
		IRON ROD
		IRON PIPE
		DRILL HOLE
		WOOD POST
	D	DEED
	P	PLAT
	M	MEASURED
	S	SURVEYED
	C	CALCULATED

I HEREBY DECLARE THAT THE ABOVE PARCEL
WAS SURVEYED DURING SEPT. 1990
PROPERTY LINES SHOWN ARE LOCATED FROM
DEEDS ON RECORD AND ARE DEED LINES.
BEARINGS ARE ASSUMED FOR ANGULAR MEASUREMENT ONLY. ALL INFORMATION SHOWN IS
TRUE AND CORRECT TO THE BEST OF MY
KNOWLEDGE AND BELIEF.



James G. Homan, Jr.
JAMES G. HOMAN, JR. P.S. #6872 DATE
ORIGINAL SIGNED IN RED INK

ENGINEERING • SURVEYING
49 SOUTH WASHINGTON STREET, TIFFIN, OHIO 44883
419-447-4300

LOCATED IN THE SW. 1/4 OF SECTION 18,
PITT TOWNSHIP, T-3-S, R-14-E,
WYANDOT COUNTY, OHIO

DRAWN BY:	CHECKED BY:	SHEET NO.
2.10 7-12-98	JCM 9-14-98	1 / 1
REVISIONS		JOB NO.
		9018-S (440)

TAX MAP COPY