


1"=30'
scale 30 0 30 60 feet

TOWNSHIP ROAD 42 40' R/W

NORTHWEST CORNER, SECTION 10
FOUND STONE IN MON. BOX

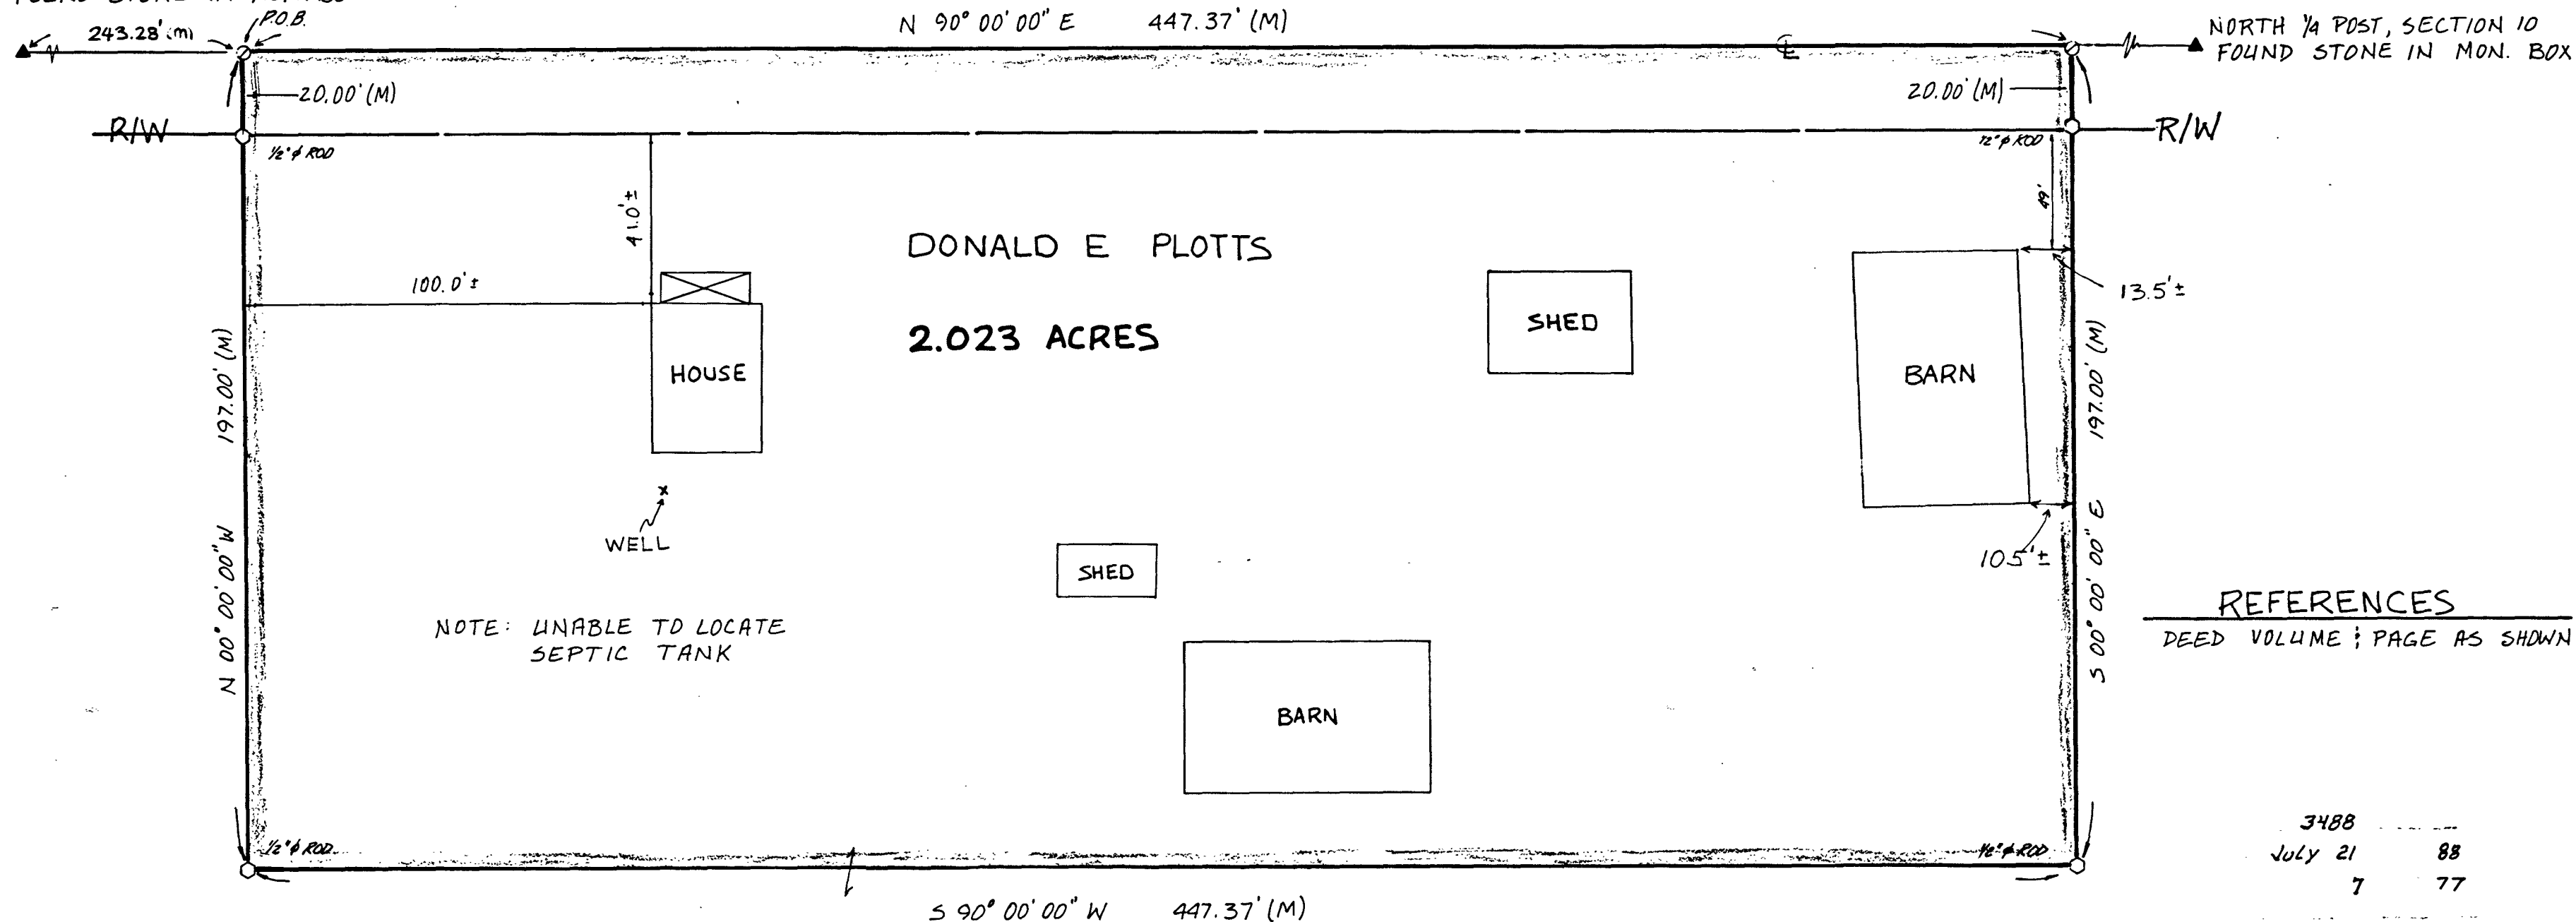

NOTE: UNABLE TO LOCATE
SEPTIC TANK

REFERENCES

DEED VOLUME ; PAGE AS SHOWN


3488
July 21 88
7 77

D. PLOTTS, ETAL
186 - 099

LEGEND

SET	FOUND	DESCRIPTION
△	▲	STONE
□	■	MONUMENT BOX
⊙	⊙	CONC. MONUMENT
⊕	⊕	RAILROAD SPIKE
○	●	NAIL
○	●	IRON ROD
○	●	IRON PIPE
○	●	DRILL HOLE
○	■	WOOD POST
D		DEED
P		PLAT
M		MEASURED
S		SURVEYED
C		CALCULATED

I HEREBY DECLARE THAT THE ABOVE PARCEL WAS
SURVEYED DURING MAY 1988.
PROPERTY LINES SHOWN ARE LOCATED FROM DEEDS
ON RECORD AND ARE DEED LINES. BEARINGS ARE
ASSUMED FOR ANGULAR MEASUREMENT ONLY. ALL
INFORMATION SHOWN IS TRUE AND CORRECT TO THE
BEST OF MY KNOWLEDGE AND BELIEF.

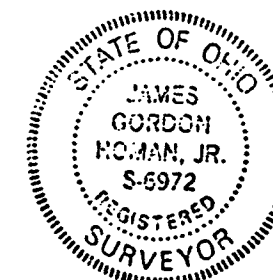

James G. Homan, Jr.
JAMES G. HOMAN, JR., P.S. NO. 6972
Original signed in red ink

SURVEY FOR: DONALD PLOTTS
BEING A PARCEL OF LAND SITUATED IN THE NORTHWEST 1/4 OF SECTION
10, T-5, R-12-E, RICHMOND TOWNSHIP, WYANDOT COUNTY, OHIO

DATE	CHECKED	DRAWN	CHECKED
GYK	X	5-10-88	
INITIAL DATE		05-04-88	

88049-S
M.F. # 245

KUSMER, MUSTERIC & ASSOCIATES
ENGINEERING ARCHITECTURE SURVEYING PLANNING
622 WEST STATE STREET
FREMONT, OHIO 43420
PHONE 419-332-1027