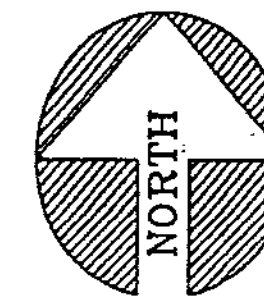
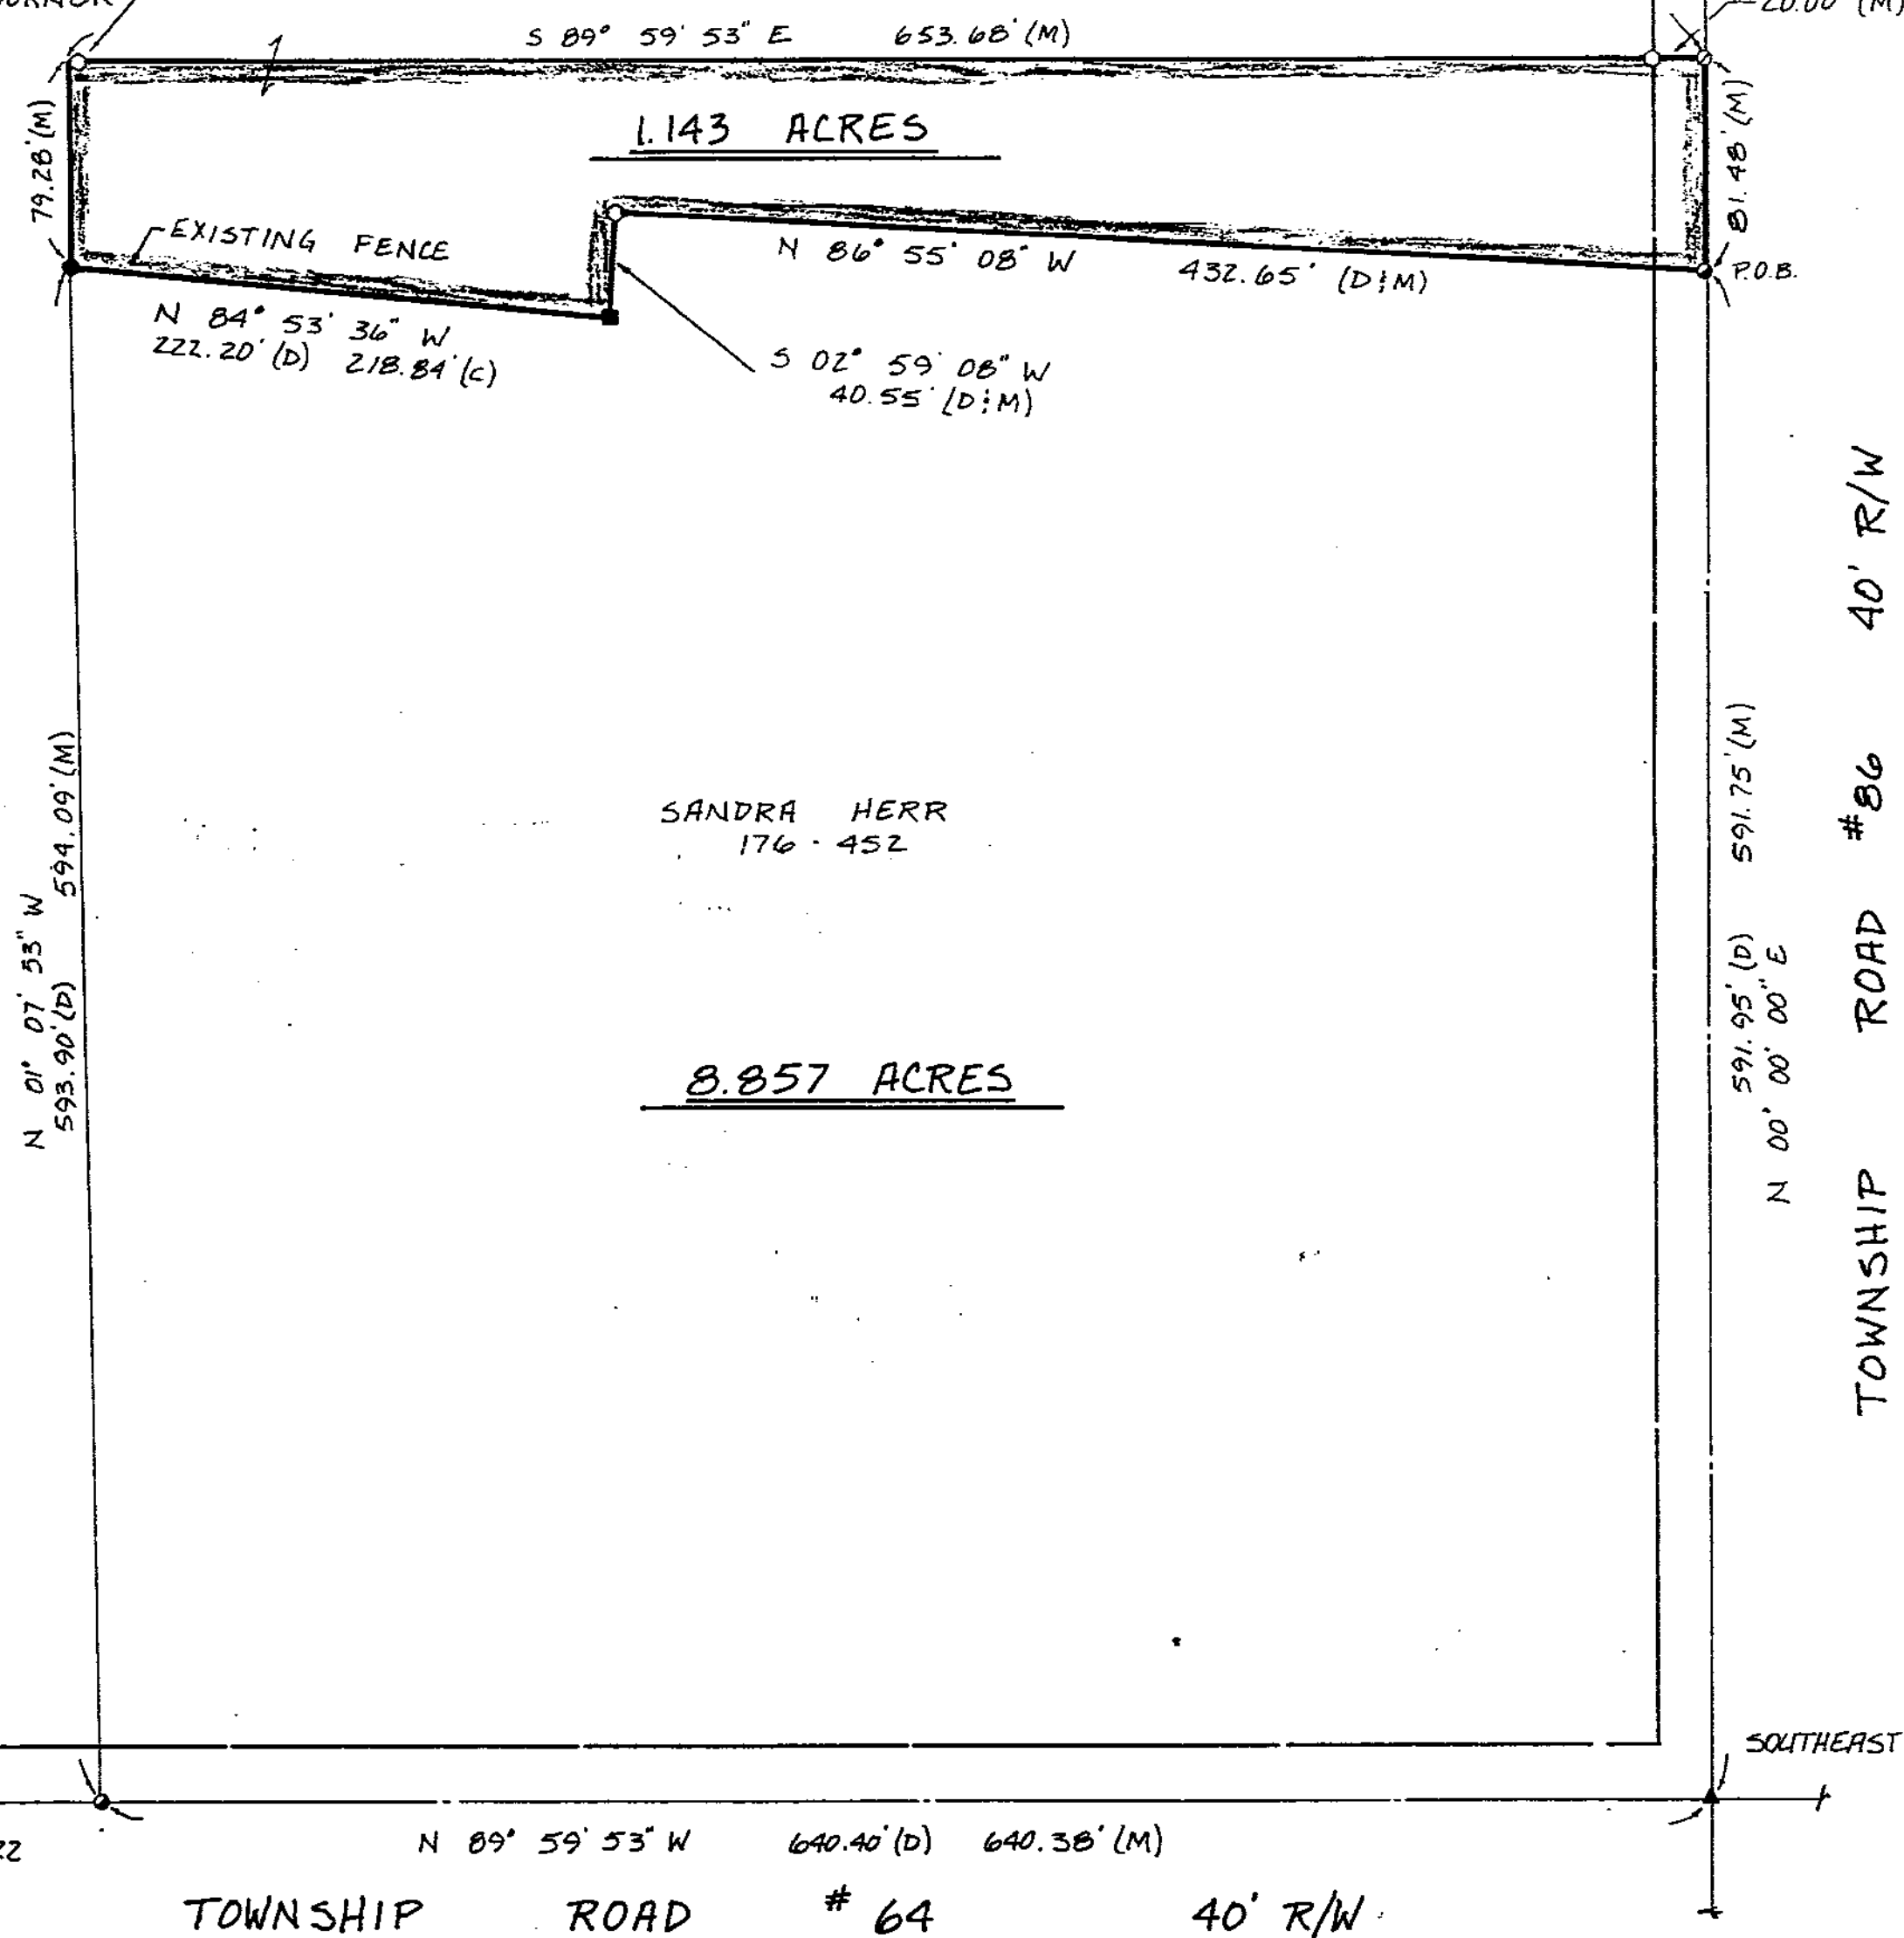


MICHAEL & CRAIG FRISCH
174-16IRON ROD SET ON TOP OF
BANK, 4.00' FROM TRUE CORNER

ASSUMED


1" = 60'
scale feet

REFERENCES

WYANDOT COUNTY CORNERSTONE
REFERENCES
SURVEY #2172 BY J. MORRIS
DEED VOLUME 1 PAGE 35 SHOWNSURVEY NO. 3502
RECORDED Sept 9 1988
IN SURVEY RECORD VOL 7 PAGE 84
TAX MAP DEPT. WYANDOT CO.

LEGEND		
SET	FOUND	DESCRIPTION
△	▲	STONE
□	□	MONUMENT BOX
⊙	⊙	CONC. MONUMENT
⊕	⊕	RAILROAD SPIKE
○	○	NAIL
○	●	IRON ROD
○	●	IRON PIPE
○	■	WOOD POST
⊙	⊙	DRILL HOLE
D		DEED
P		PLAT
M		MEASURED
S		SURVEYED

I hereby declare that the above parcel was surveyed during APRIL 1988.
Property lines shown are located from deeds on record and are deed lines.
Bearings are assumed and for angular measurement only. All information shown is true and correct to the best of my knowledge and belief.

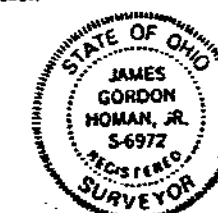

James G. Homan, Jr.

ORIGINAL SIGNED IN RED INK

KUSMER, MUSTERIC & ASSOCIATES

PHONE 419 332 1027

FREMONT, OHIO 43420

622 WEST STATE STREET

SURVEY FOR: DICK HATCHER

BEING A PARCEL OF LAND SITUATED IN THE
SE 1/4 OF SECTION 22, T-3-S, R-12-E,
JACKSON TOWNSHIP, WYANDOT COUNTY, OHIO.

DATE	PREPARED	FILED
APR 29 1988	APR 29 1988	APR 29 1988
BY	BY	BY
JAMES G. HOMAN, JR.	JAMES G. HOMAN, JR.	JAMES G. HOMAN, JR.

88044-S

MAY 03 1988

(231)