


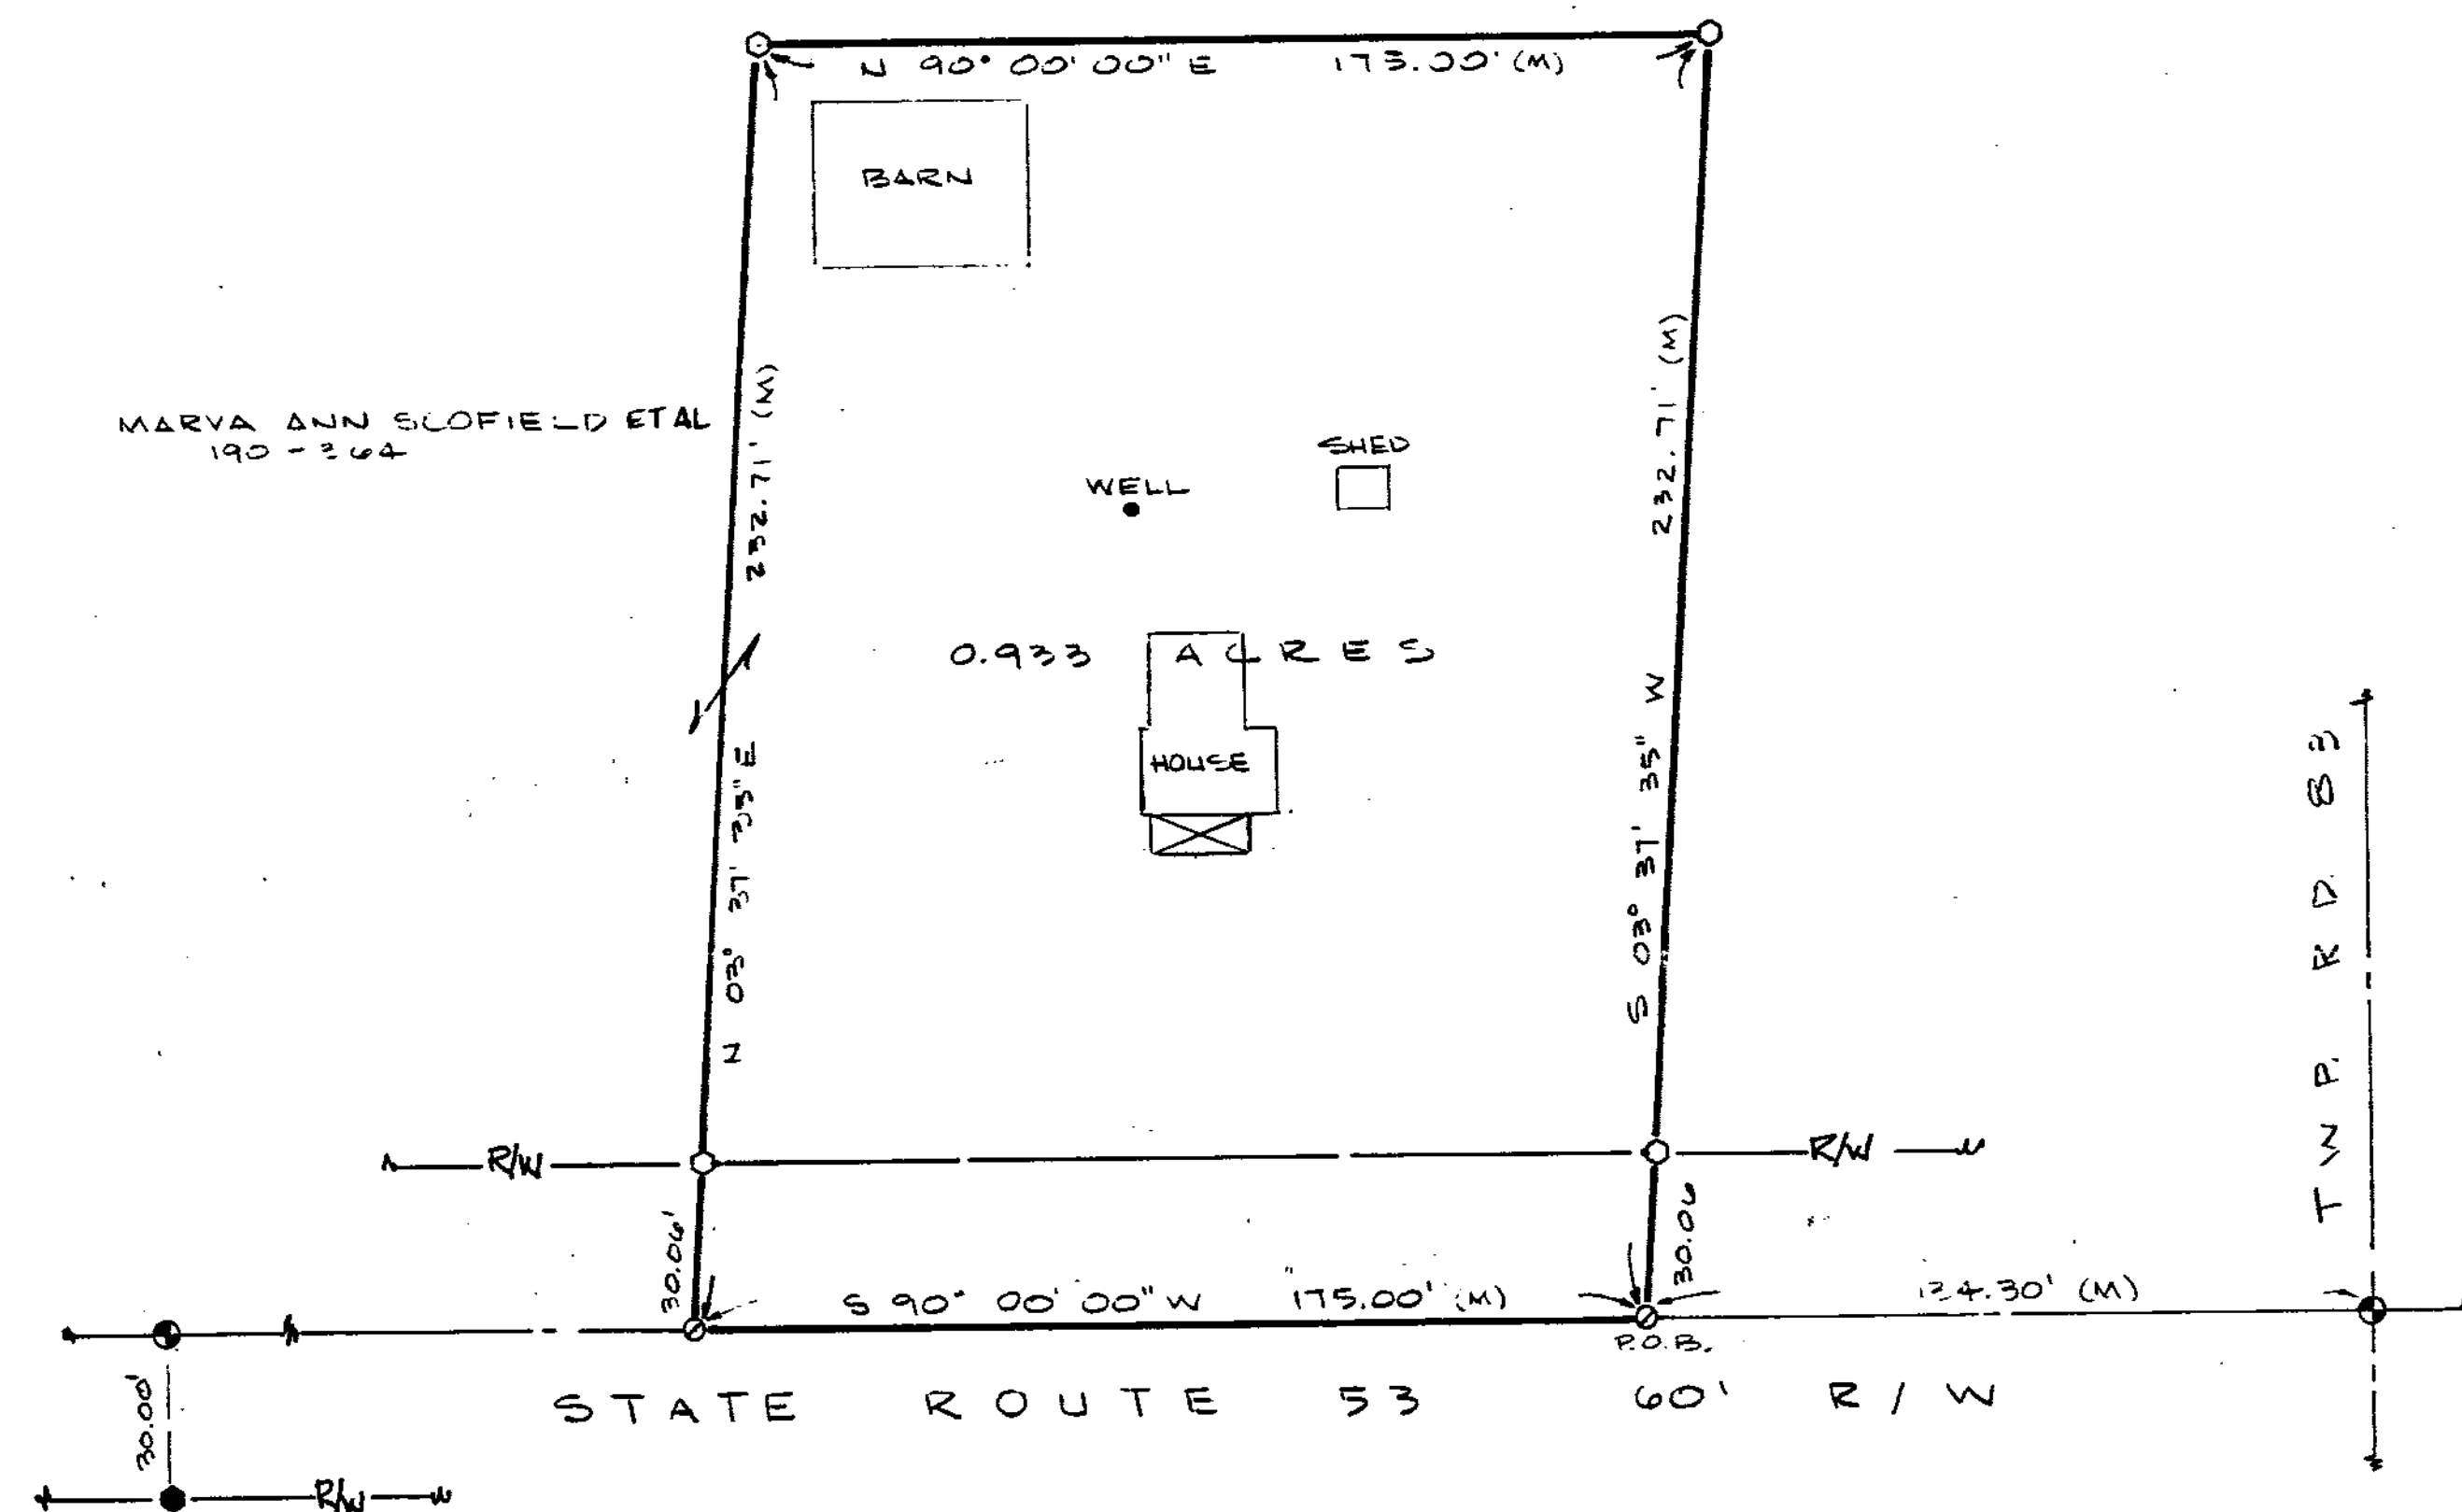

### REFERENCES

DEEDS AS NOTED


SURVEY FOR MARY BAKER BY  
JACQUES GLAZE 3-16-88  
#2465

WYANDOT COUNTY REFERENCES


### LEGEND

|   |                              |
|---|------------------------------|
| ○ | IRON ROD W/ PERSONALIZED CAP |
| ● | IRON ROD                     |
| ■ | FENCE POST                   |
| ▲ | STONE                        |
| □ | MONUMENT BOX                 |
| D | DEED                         |
| P | PLAT                         |
| M | MEASURED                     |
| C | CALCULATED                   |
| S | DIAMETER                     |
| ○ | IRON PIPE                    |
| ○ | DRILL HOLE                   |
| ○ | NAIL                         |
| ○ | RAILROAD CH                  |
| ○ | MONUMENT                     |
| ○ | RE-SPIKE                     |

THIS SURVEY WAS MADE BY THE ABOVE NAMED SURVEYOR IN SEPTEMBER, 1988.  
THE SURVEY WAS MADE BY THE ABOVE NAMED SURVEYOR IN SEPTEMBER, 1988.  
ON RECORD AND ARE DEED LINES. BEARINGS ARE ASSUMED FOR ANGULAR MEASUREMENT ONLY. ALL INFORMATION GIVEN IS TRUE AND CORRECT TO THE BEST OF MY KNOWLEDGE AND BELIEF.

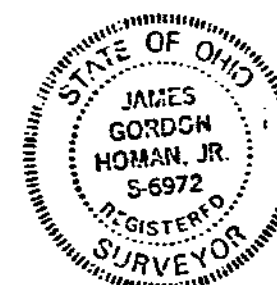

James G. Homan, Jr. 10-7-88  
JAMES G. HOMAN, JR., P.S. #6972 DATE  
ORIGINAL SIGNED IN RED INK

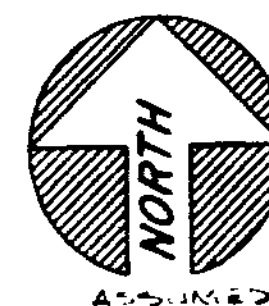

1"=30'  
Scale 0 30 60 feet

3516  
Oct 21 88  
7 88

KUSMER, MUSTERIC &amp; ASSOCIATES, INC.

PHONE 418-332-1027

FREMONT, OHIO 43420

822 WEST STATE STREET

SURVEY FOR M. SCOFIELD

BEING PART OF SE 1/4, SW 1/4, SEC. 3  
TOWNSHIP 3-SOUTH, RANGE-12-EAST, JACKSON  
TWP. WYANDOT COUNTY, OHIO.

|          |         |
|----------|---------|
| DATE     | 10-7-88 |
| BY       | JGH     |
| INITIALS | JGH     |
| DATE     | 10-7-88 |
| BY       | JGH     |
| INITIALS | JGH     |
| DATE     | 10-7-88 |
| BY       | JGH     |
| INITIALS | JGH     |

881153  
(419)