


TAX MAP COPY

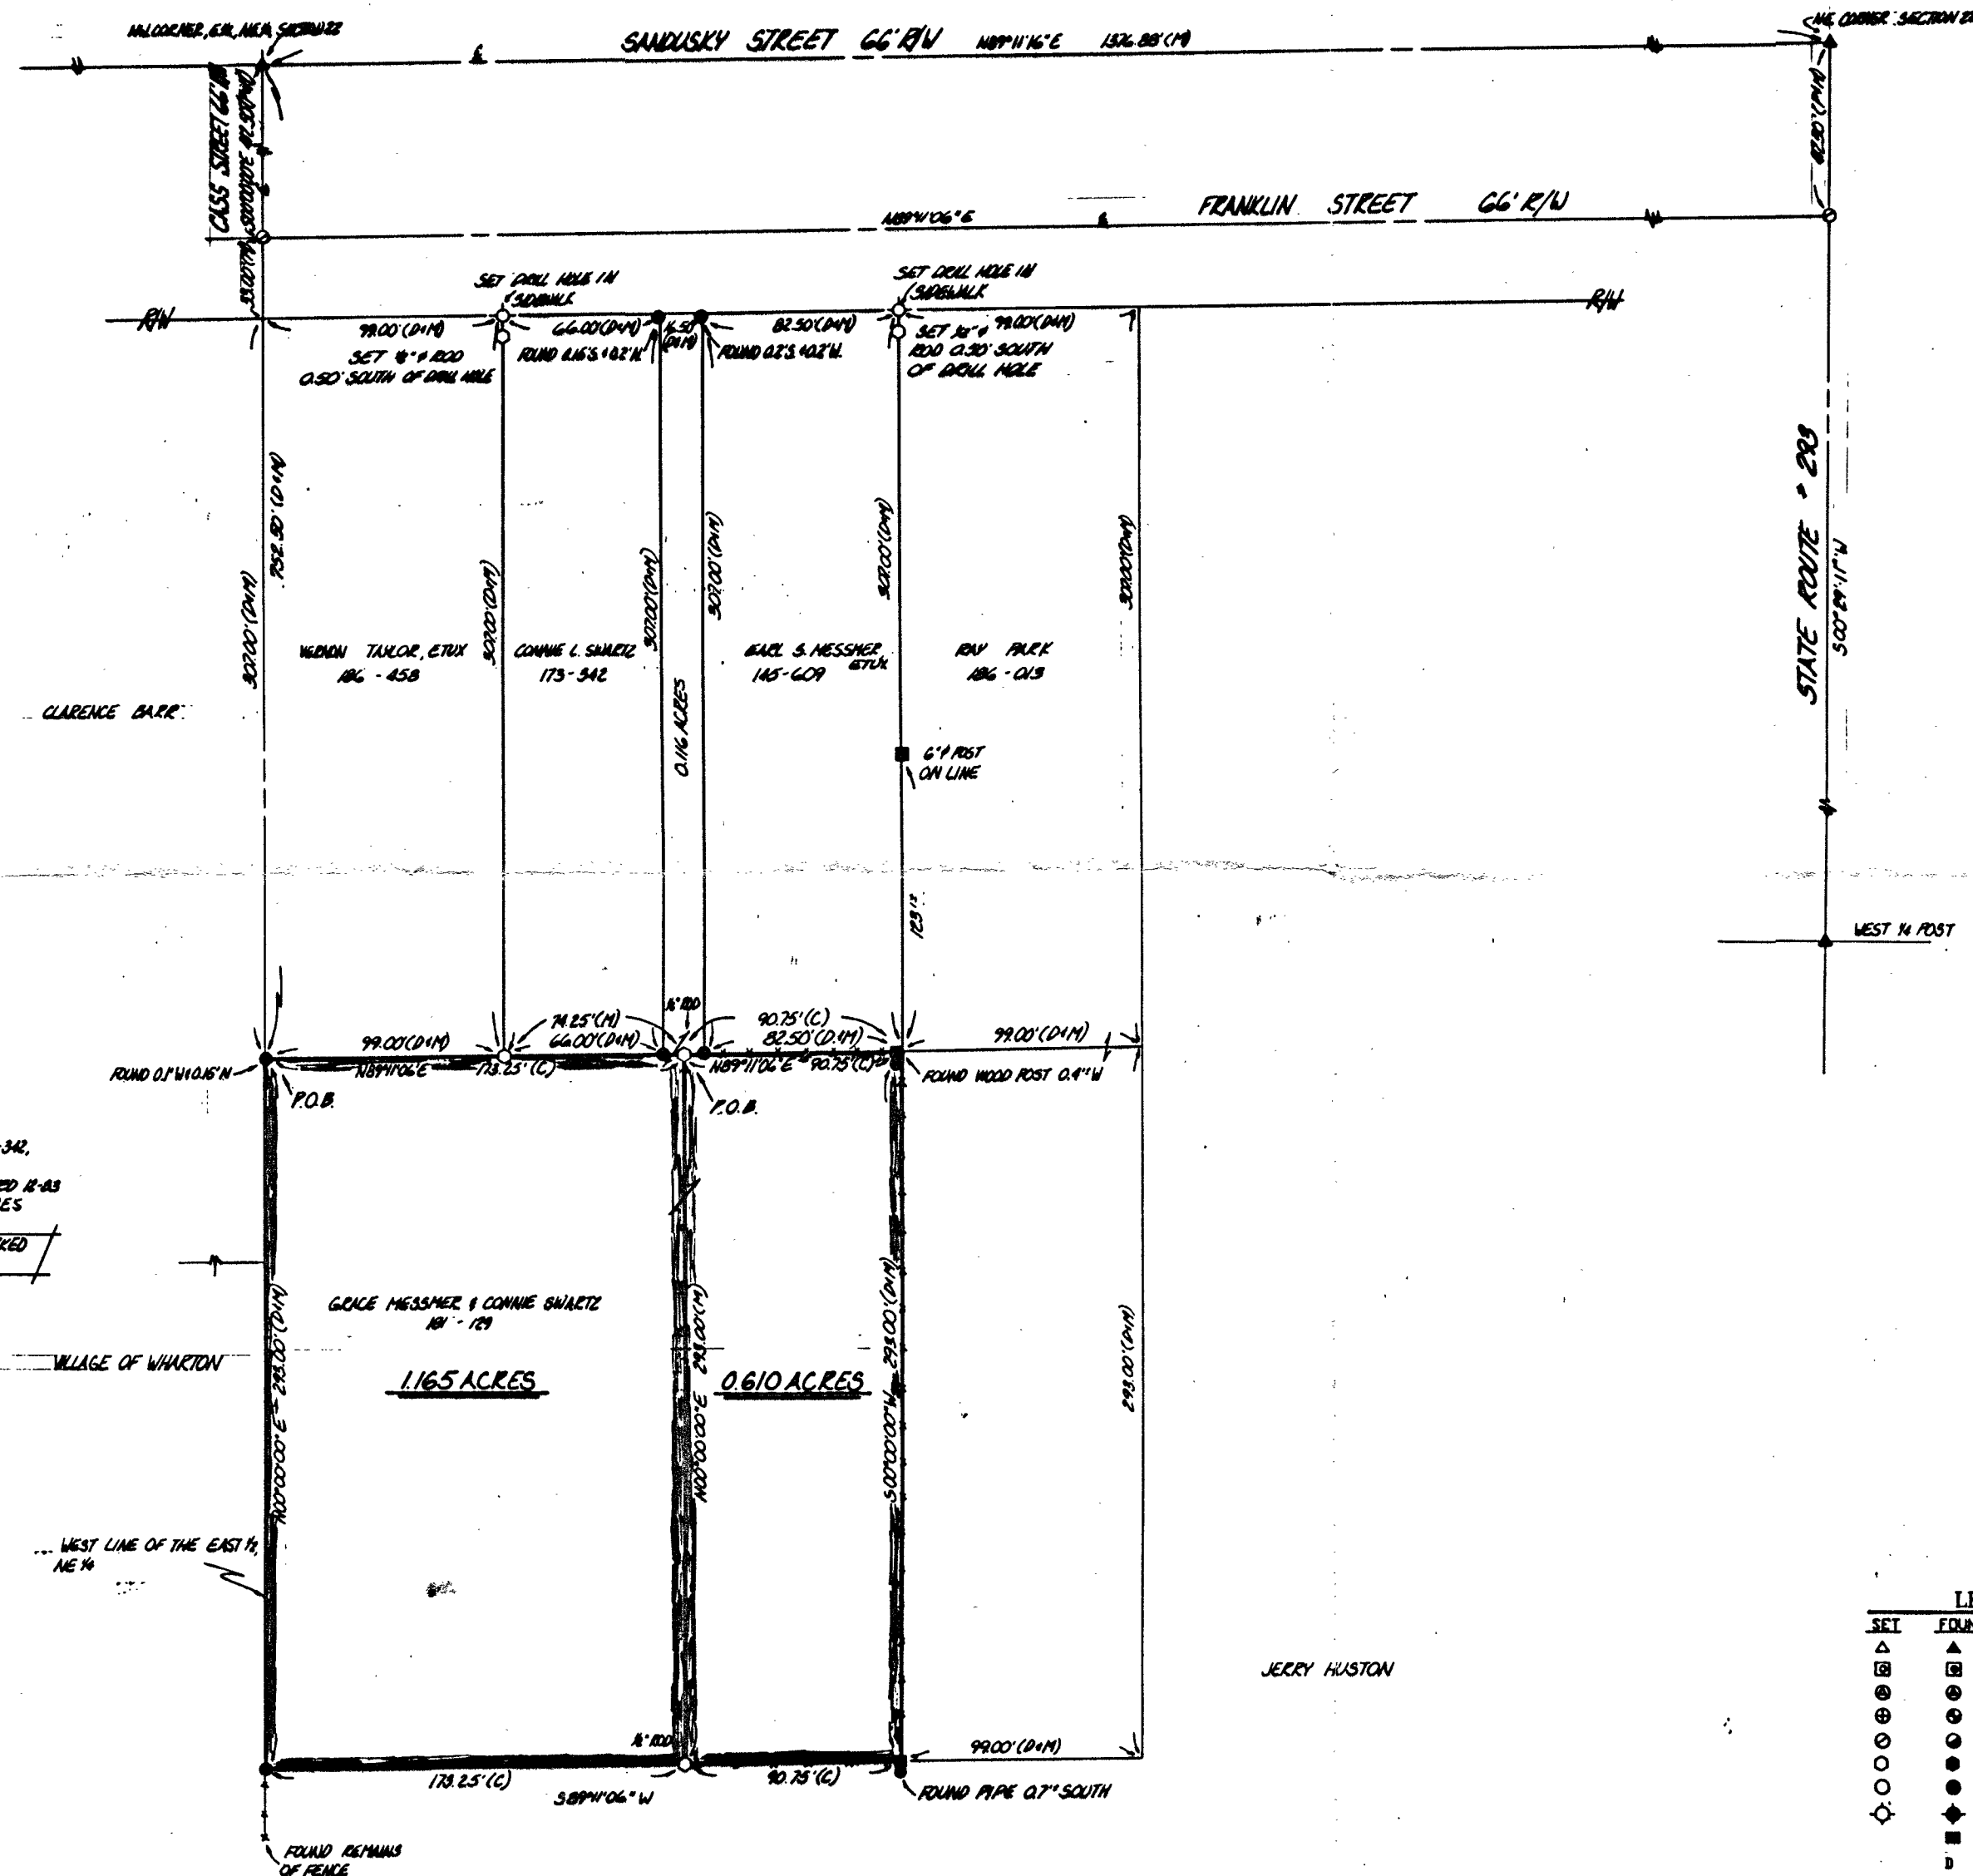

REFERENCES:

REED VOLUMES AS LISTED: 181-129, 130, 173-342,
139-047, 139-045, 139-043 AND 98-437
SURVEY BY J. B. WENINGER FOR M. OGG DATED 12-83
WYANDOT COUNTY ENGINEERS REFERENCES
PLAT VOLUME 2, PAGES 55, 127, 139, 147
NOTE: ALL ROUND PIPES HAD CAPS MARKED
R/S. 5647

GRACE MESSMER & CONNIE SWARTZ
194 - 179

1.165 ACRES

0.610 ACRES

JERRY HUSTON

SURVEY NO. 3568
RECORDED MAY 4 1989
IN SURVEY RECORD VOL 7 PAGE 26
TAX MAP MAPS DIVISION CO.

I HEREBY DECLARE THAT THE ABOVE PARCEL WAS SURVEYED DURING JUNE, 1999. PROPERTY LINES SHOWN ARE LOCATED FROM RECORDS ON RECORDS AND ARE DEED LINES. MEASUREMENTS ARE ASSUMED FOR ANGULAR MEASUREMENT ONLY. ALL INFORMATION SHOWN IS TRUE AND CORRECT TO THE BEST OF MY KNOWLEDGE AND BELIEF.

A circular seal for the State of Ohio. The outer ring contains the text "STATE OF OHIO" at the top and "REGISTERED SURVEYOR" at the bottom. In the center, the name "JAMES GORDON NOLAN, JR." is written in three lines, followed by the number "8-6972" on the fourth line.

James G. Homan, Jr.
JAMES G. HOMAN, JR., P.R. NO. 6072
Original signed in red ink;

LEGEND		
SET	FOUND	DESCRIPTION
▲	▲	STONE
⊠	⊠	MONUMENT BOX
⊞	⊞	CONC. MONUMENT
⊕	⊕	RAILROAD SPIKE
○	●	MAIL
○	●	IRON ROD
○	●	IRON PIPE
⊙	⬮	DRILL HOLE
	■	WOOD POST
	D	DEED
	P	PLAT
	M	MEASURED
	S	SURVEYED
	C	CALCULATED

KUSMER, MUSTER & ASSOCIATES, INC.

SURVEY FOR: CONNIE SUMETS AND GRACE MESSMER
BEING A PARCEL OF LAND SITUATED IN PART OF THE NORTHEAST QUARTER SECTION
22, T2S, R2E, RICHMOND TOWNSHIP, VILLAGE OF WHARREN, WYANDOT COUNTY.

EXISTING		PROPOSED	
DRAWN	CHECKED	DRAWN	CHECKED
<i>PC</i>	<i>Jed</i> <i>7-2-03</i>		
INITIAL - DATE		REVISIONS	
<i>PC</i> <i>7-2</i>		<i>add 41135</i> <i>7-2-03</i>	

88070-

(311)