


WARPOLE STREET

SPRING STREET 50' R/W

EIGHTH STREET

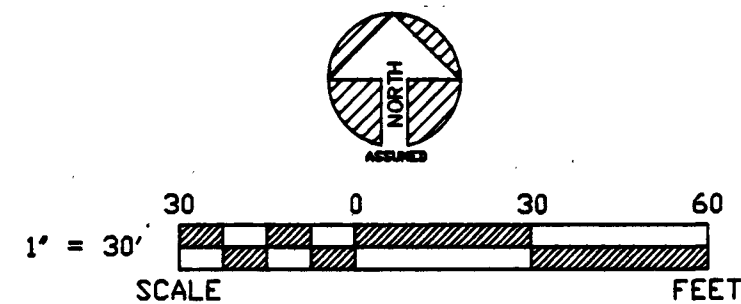

REFERENCES

DEED VOLUME AND PAGE AS SHOWN

WYANDOT COUNTY CORNERSTONE REFERENCES

PLAT VOLUME 3, PAGE 54

SURVEY VOLUME 5, PAGE 390

SURVEY NO. 3680
VOL 7 PAGE 121
DATE JUNE 25, 1990

GALE SMITH

BEING LOTS 108, 109, 110, 111, 112, 113 AND
A VACATED ALLEY IN SOUTH PARK SUBDIVISION
CITY OF UPPER SANDUSKY, WYANDOT COUNTY, OHIO

HANK AND ASSOCIATES, INC.

ENGINEERING SURVEYING
WASHINGTON STREET
49 SOUTH OHIO 44883
TIFFIN, OHIO (419) 447-4300

JOB NO.

90002-S
(62)

SHEET NO.

1 / 1

REVISIONS

CHECKED BY:

JCA 6-13-90

DRAWN BY:

DJN
6-2-90


POINTS FALL
IN FIELD
TO BE SET AT
A LATER DATE

FAIRVIEW STREET 50' R/W

MAPLE STREET

EULALIA STREET

HAZEL STREET 50' R/W

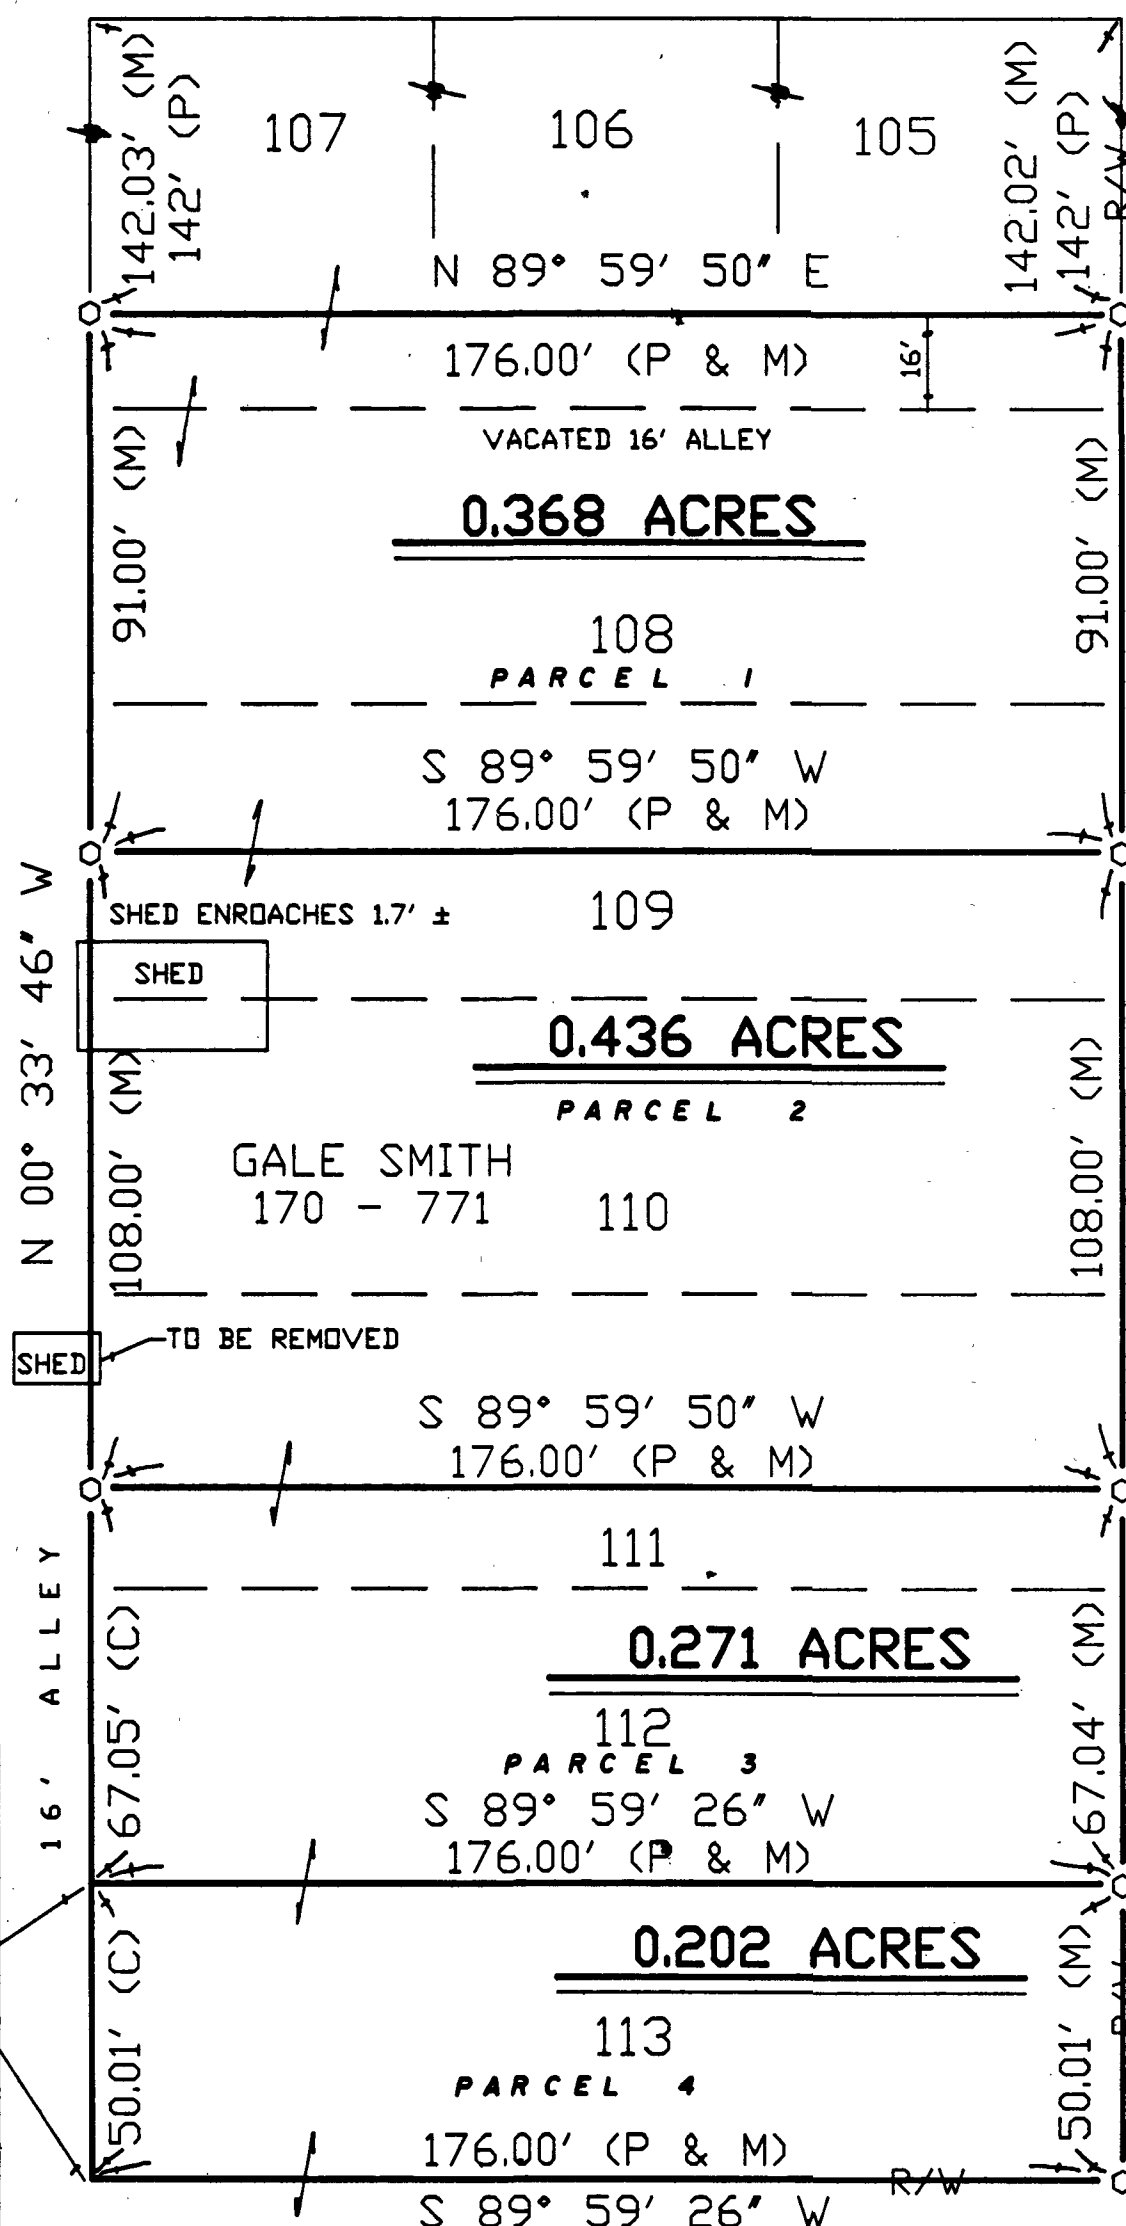

P.O.B.

P.O.B.

P.O.B.

P.O.B.


LEGEND

SET	FOUND	DESCRIPTION
△	▲	STONE
□	■	MONUMENT BOX
⊙	⊙	CONC. MONUMENT
⊕	⊕	RAILROAD SPIKE
○	○	NAIL
○	○	IRON ROD
○	○	IRON PIPE
○	○	DRILL HOLE
○	○	WOOD POST
D	D	DEED
P	P	PLAT
M	M	MEASURED
S	S	SURVEYED
C	C	CALCULATED

NOTE: ALL IRON ROD SET ARE 1/2" DIA. WITH
PERSONALIZED CAPS (HANK # 6972)
DRIVEN FLUSH.

I HEREBY DECLARE THAT THE ABOVE PARCEL WAS
SURVEYED DURING MAY, 1990

PROPERTY LINES SHOWN ARE LOCATED FROM RECORDS
ON RECORD AND ARE DEED LINES. BEARINGS ARE
ASSUMED FOR ANGULAR MEASUREMENT ONLY. ALL
INFORMATION SHOWN IS TRUE AND CORRECT TO THE
BEST OF MY KNOWLEDGE AND BELIEF.

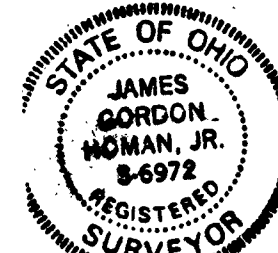

James G. Homan, Jr. 6-13-90
JAMES G. HOMAN, JR., P.S. # 6972 DATE
ORIGINAL SIGNED IN RED INK