
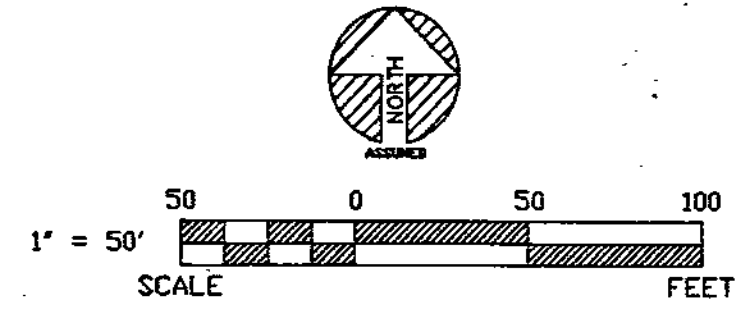


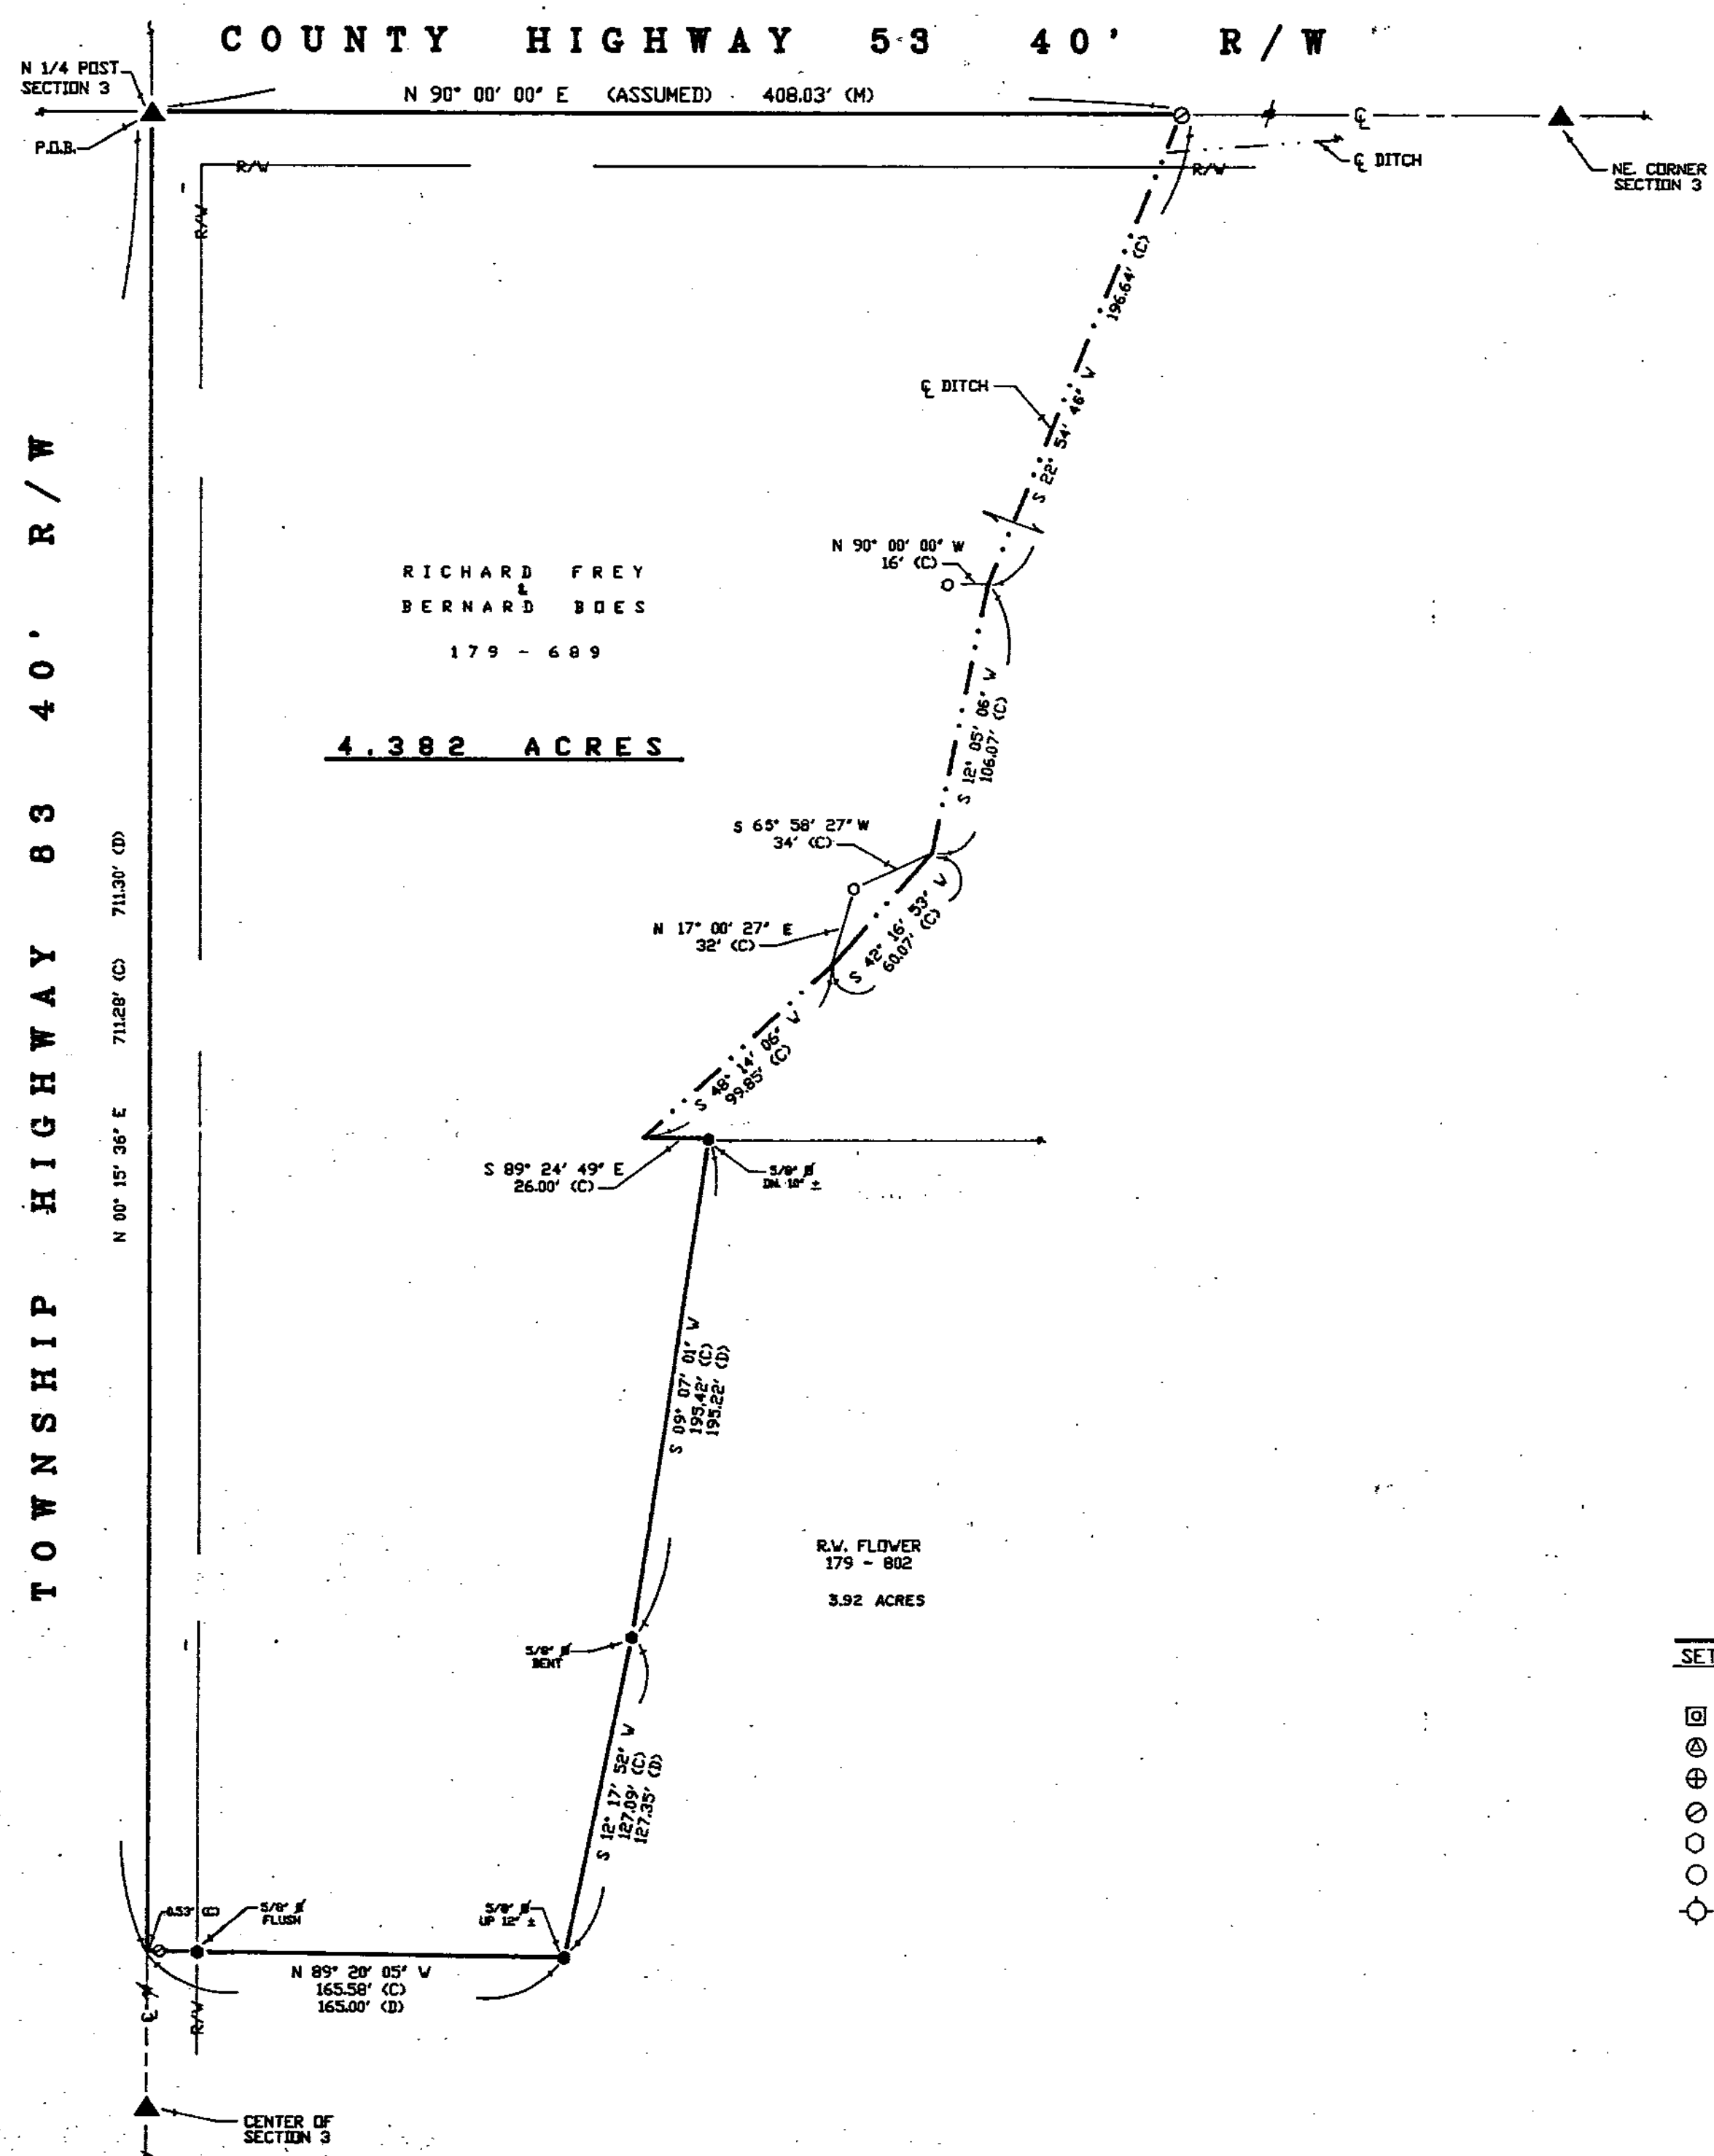

REFERENCES
DEED VOLUME AND PAGE AS SHOWN
WYANDOT COUNTY CORNERSTONE REFERENCES
SURVEY VOLUME 3, PAGE 401
SURVEY VOLUME 6, PAGE 50
SURVEY NO. 3717
VOL 7 PAGE 129
DATE Nov 9, 1990

NOTE: ALL IRON ROD SET ARE 1/2" DIA. WITH PERSONALIZED CAPS (HANK # 6972) DRIVEN FLUSH.

SET	FOUND	DESCRIPTION
▲	▲	STONE
■	■	MONUMENT BOX
⊕	⊕	CONC. MONUMENT
⊗	⊗	RAILROAD SPIKE
○	○	NAIL
○	○	IRON ROD
○	○	IRON PIPE
○	○	DRILL HOLE
○	○	WOOD POST
D	D	DEED
P	P	PLAT
M	M	MEASURED
C	C	CALCULATED
⊙	⊙	DIAMETER

I HEREBY DECLARE THAT THE ABOVE PARCEL WAS SURVEYED DURING OCT. - NOV. 1990. PROPERTY LINES SHOWN ARE LOCATED FROM DEEDS ON RECORD AND ARE DEED LINES. BEARINGS ARE ASSUMED FOR ANGULAR MEASUREMENT ONLY. ALL INFORMATION SHOWN IS TRUE AND CORRECT TO THE BEST OF MY KNOWLEDGE AND BELIEF.



James G. Homan, Jr. 11-06-90
JAMES G. HOMAN, JR., P.S. # 6972 DATE
ORIGINAL SIGNED IN RED INK

JOB NO.	90126-S (491)
ENGINEERING	WASHINGTON STREET SOUTH TIFFIN, OHIO 44883 (419) 447-4300
SURVEY FOR	RICHARD FREY LOCATED IN THE NE 1/4 OF SECTION 3, JACKSON TOWNSHIP, T-3-S, R-12-E, WYANDOT COUNTY, OHIO
DRAWN BY	D.J.W. 11-05-90
CHECKED BY	R.C.H. 11-06-90
REVISIONS	1
SHEET NO.	1