
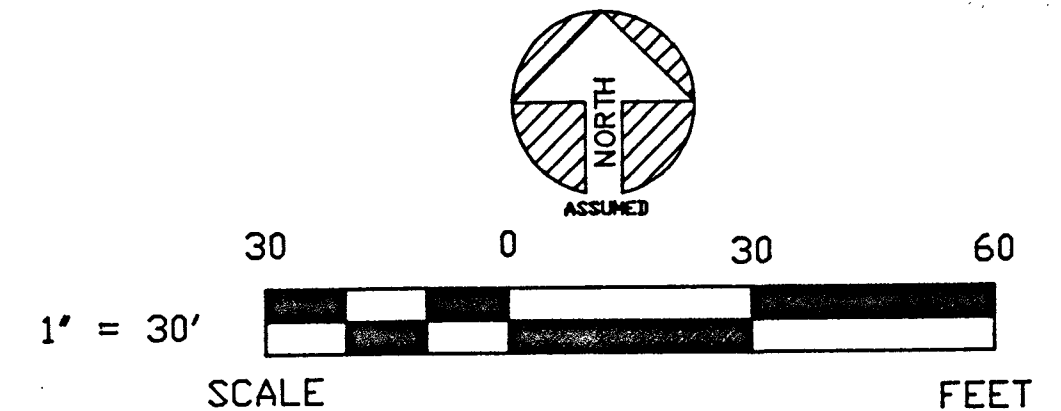


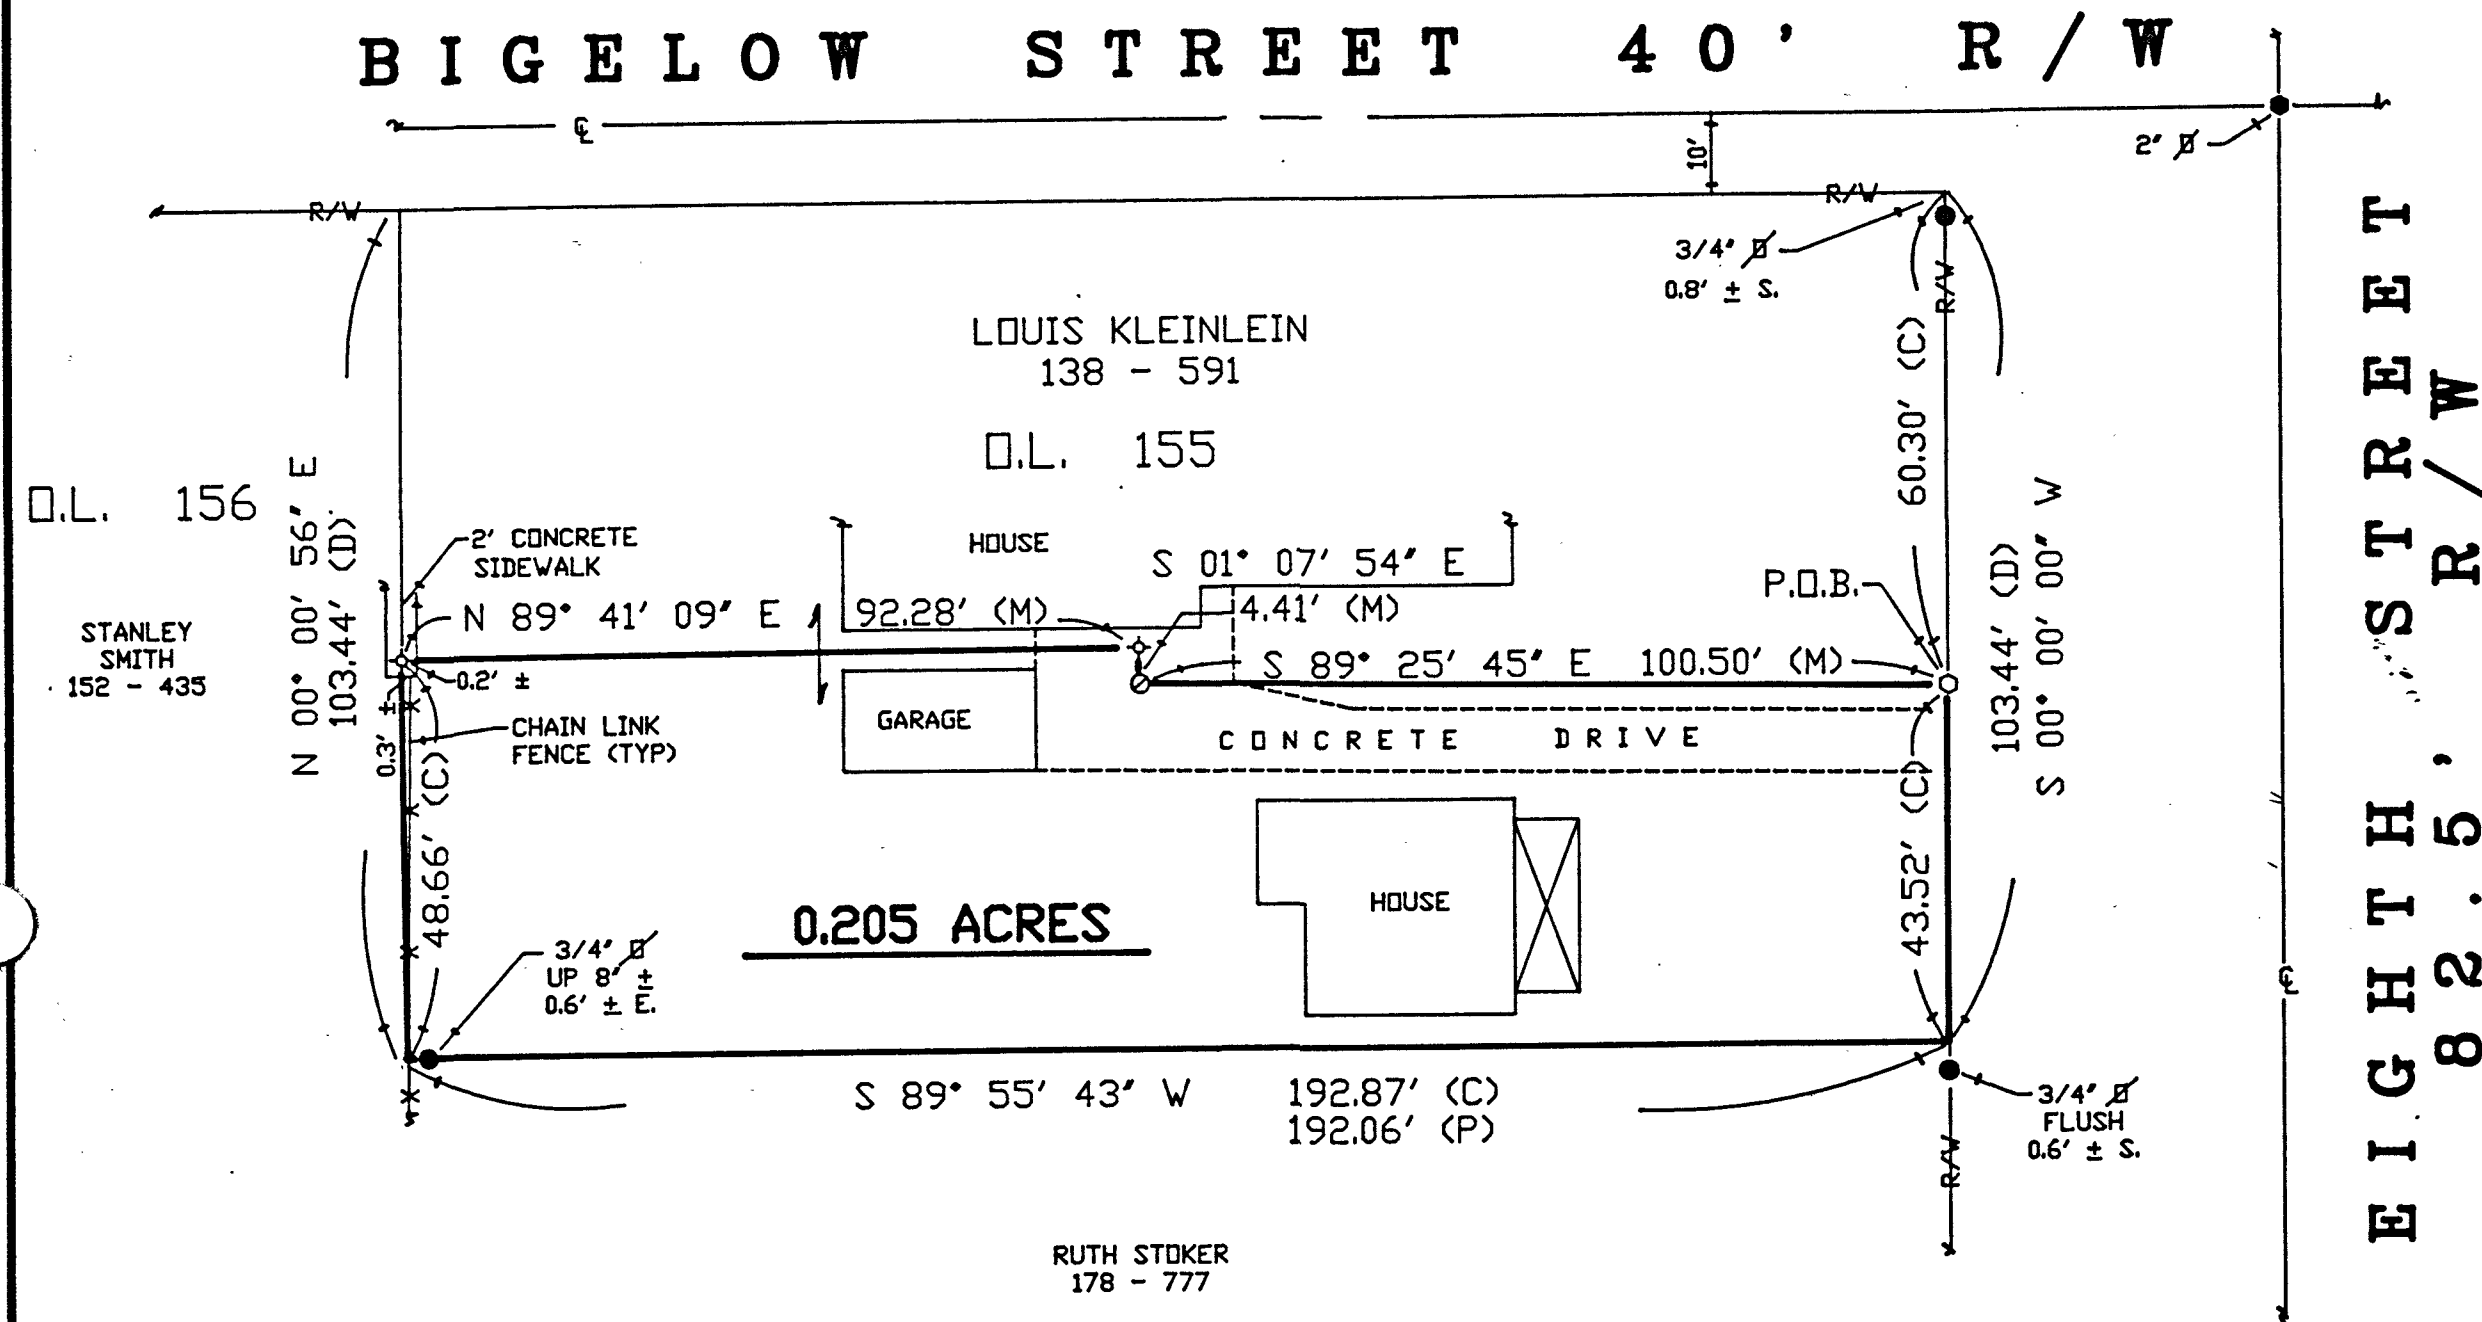

REFERENCES

DEED VOLUME & PAGE AS SHOWN
 PLAT VOLUME 1, PAGE 40
 SURVEY VOLUME 4, PAGE 61
 SURVEY VOLUME 7, PAGE 63

NOTE: ALL IRON ROD SET ARE 1/2" DIA. WITH PERSONALIZED CAPS (HANK # 6972) DRIVEN FLUSH.

SURVEY NO. 3728
 VOL 7 PAGE 134
 DATE 12-24-90

LEGEND

SET	FOUND	DESCRIPTION
△	▲	STONE
□	■	MONUMENT BOX
⊕	⊙	CONC. MONUMENT
⊗	⊘	RAILROAD SPIKE
⊙	●	NAIL
⊗	⊘	IRON ROD
⊙	●	IRON PIPE
⊗	⊘	DRILL HOLE
⊙	●	WOOD POST
	D	DEED
	P	PLAT
	M	MEASURED
	S	SURVEYED
	C	CALCULATED

I HEREBY DECLARE THAT THE ABOVE PARCEL WAS SURVEYED DURING DECEMBER, 1990.
 PROPERTY LINES SHOWN ARE LOCATED FROM DEEDS ON RECORD AND ARE DEED LINES. BEARINGS ARE ASSUMED FOR ANGULAR MEASUREMENT ONLY. ALL INFORMATION SHOWN IS TRUE AND CORRECT TO THE BEST OF MY KNOWLEDGE AND BELIEF.



James G. Homan, Jr.
JAMES G. HOMAN, JR., P.S. #6972 DATE 12-21-90
 ORIGINAL SIGNED IN RED INK

HANK AND ASSOCIATES, INC.

ENGINEERING • SURVEYING

49 SOUTH WASHINGTON STREET, TIFFIN, OHIO 44883
 419-447-4300

SURVEY FOR: **ERIC PARKS**

BEING PART OF OUTLOT 155 OF THE ORIGINAL PLAT
 OF THE CITY OF UPPER SANDUSKY,
 WYANDOT COUNTY, OHIO

DRAWN BY: CHECKED BY: SHEET NO.

DJN 12-21-90 JGH 12-21-90 1/1

REVISIONS JOB NO.

90148-S
 (538)