
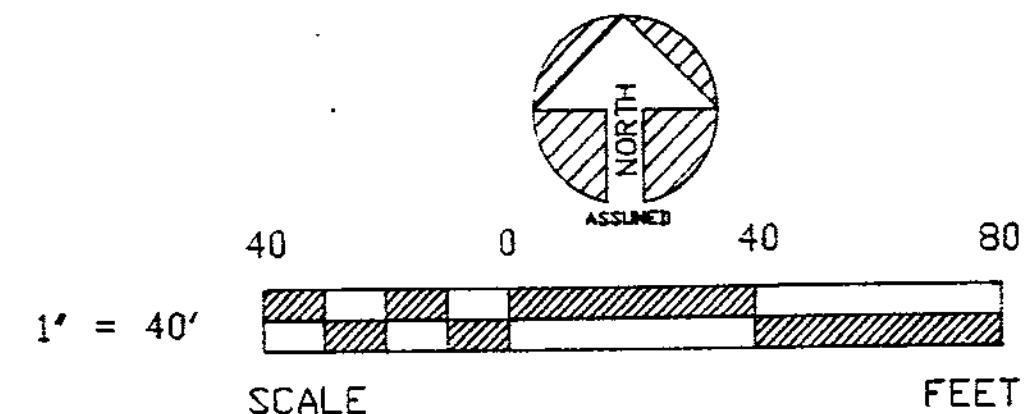


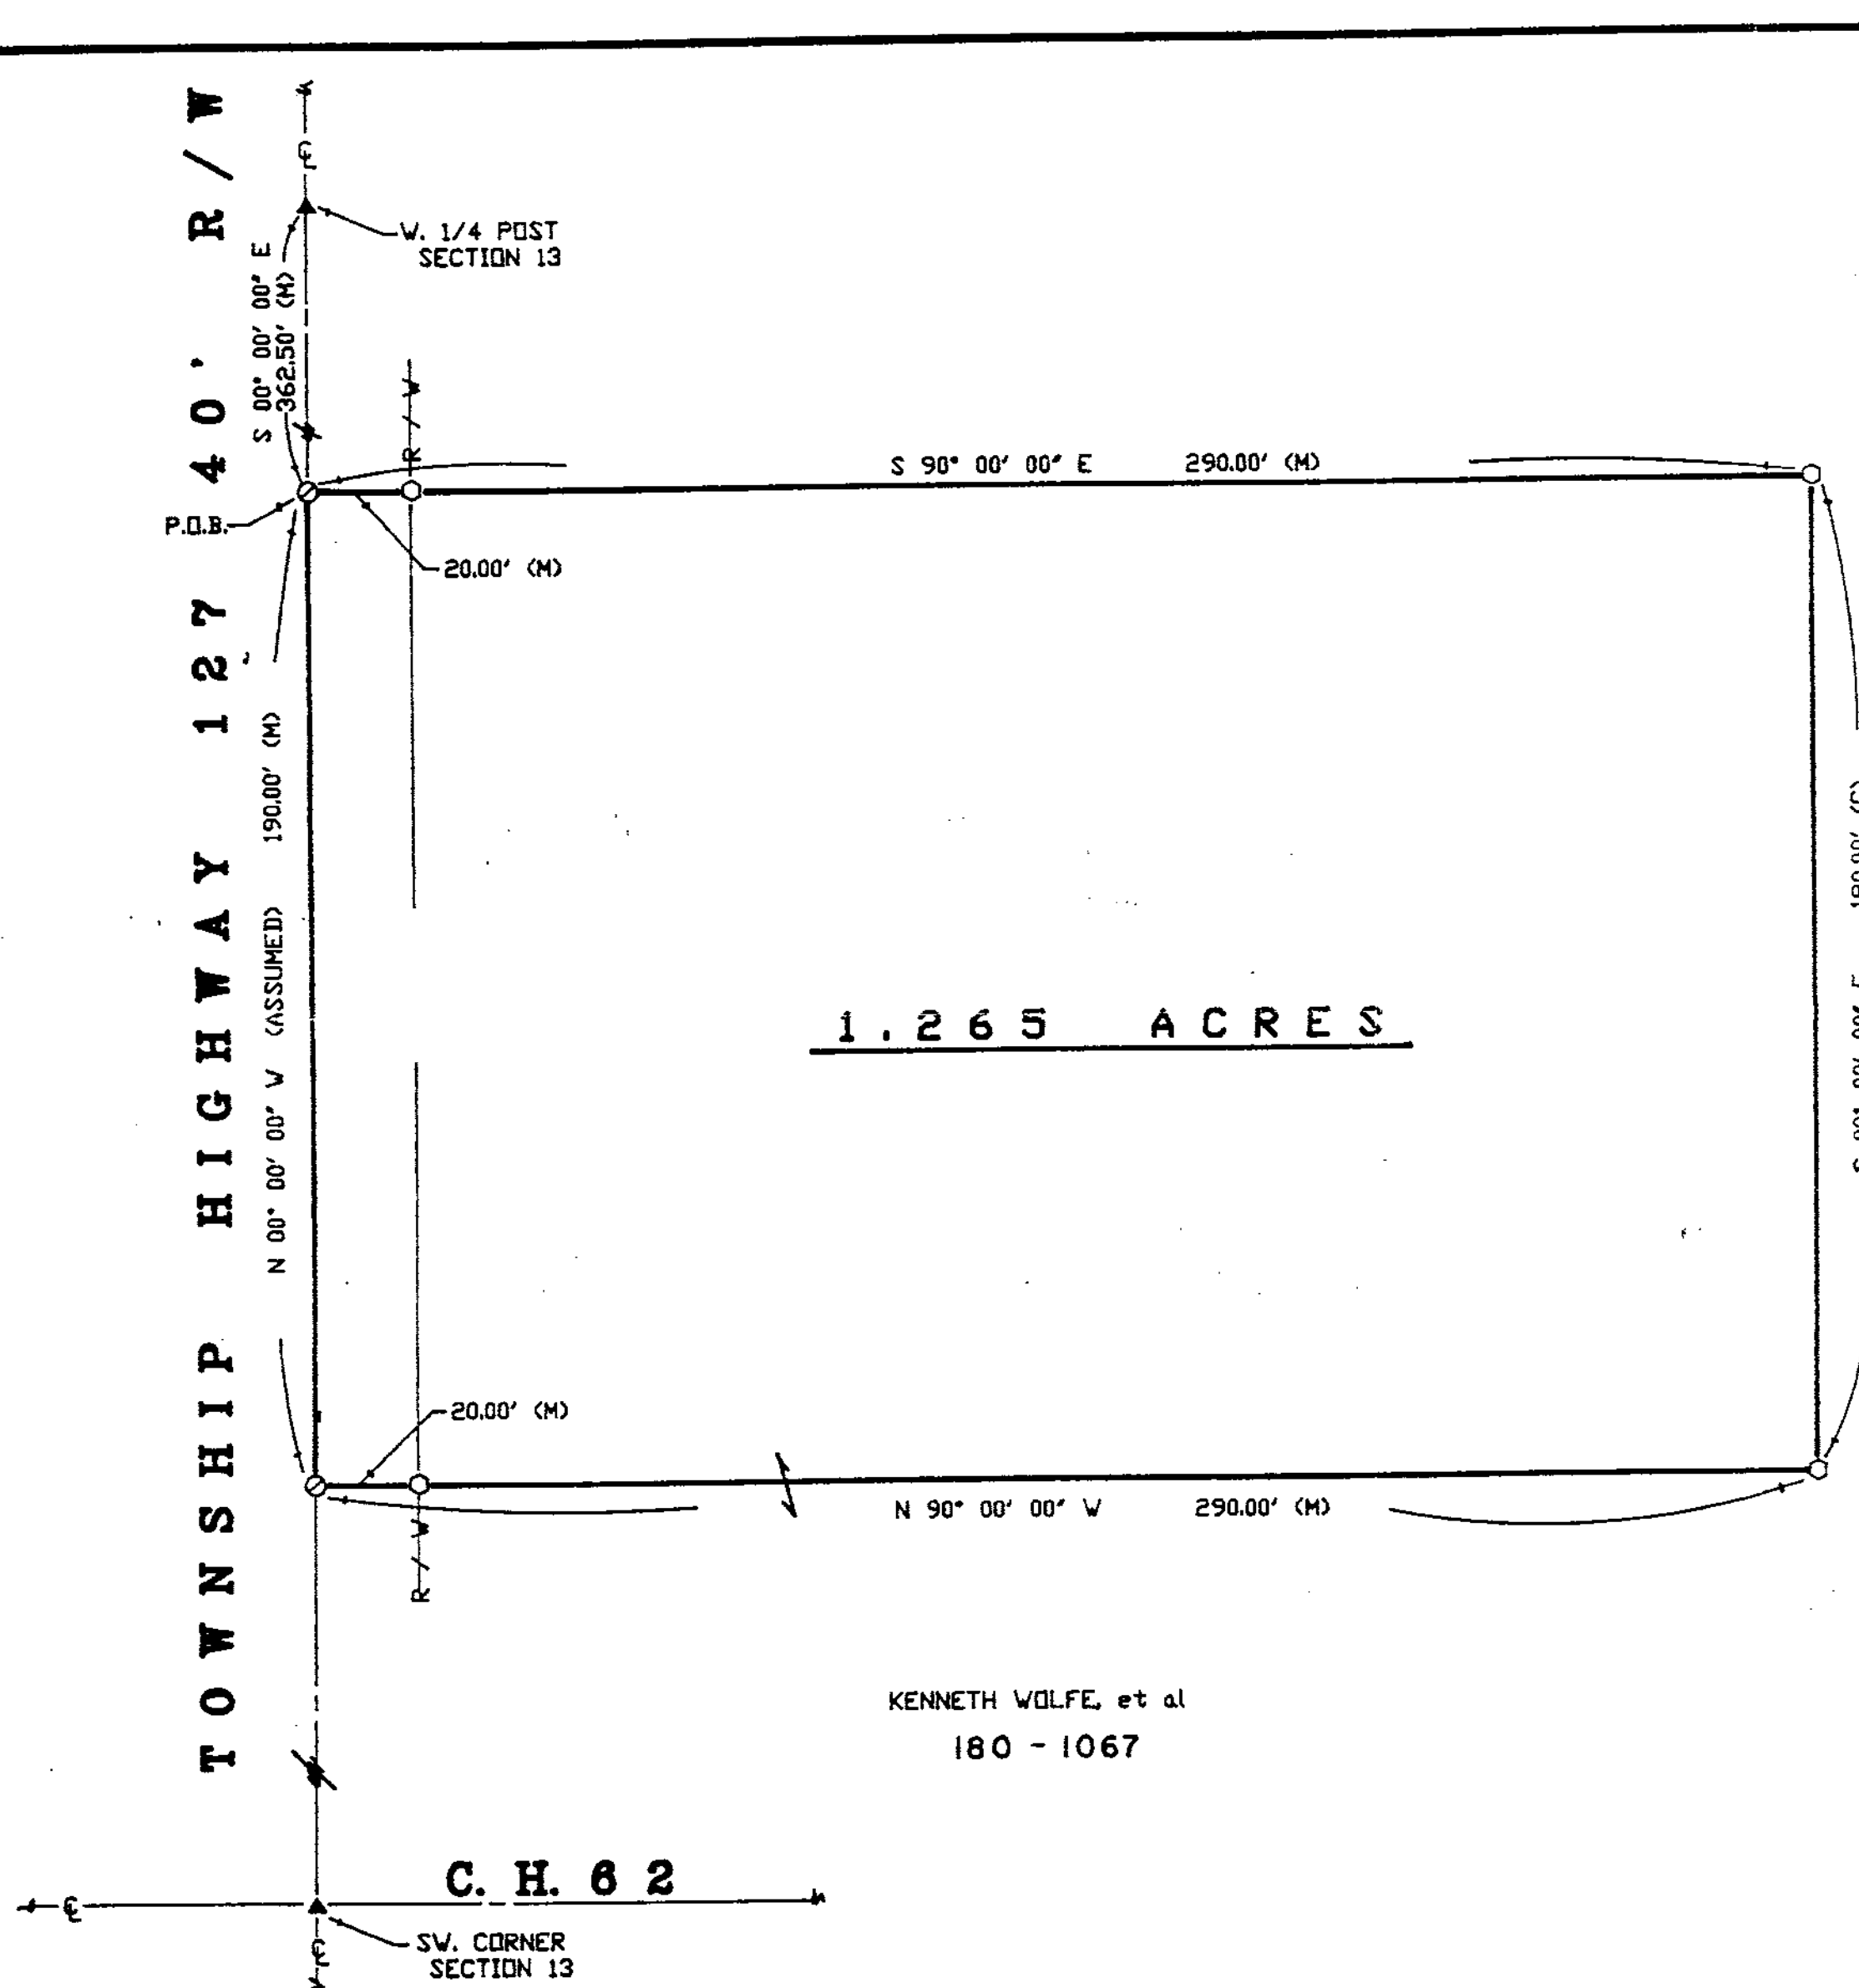

REFERENCES

DEED VOLUME & PAGE AS SHOWN
WYANDOT COUNTY CORNERSTONE REFERENCES


SURVEY NO. 9117
VOL 7 PAGE 152
DATE April 16, 1991

NOTE: ALL IRON ROD SET ARE 1/2" DIA. WITH
PERSONALIZED CAPS (HANK # 6972)
DRIVEN FLUSH.

LEGEND

SET	FOUND	DESCRIPTION
△	▲	STONE
□	■	MONUMENT BOX
⊕	⊙	CONC. MONUMENT
⊗	⊗	RAILROAD SPIKE
⊙	●	NAIL
⊗	●	IRON ROD
⊙	●	IRON PIPE
⊗	●	DRILL HOLE
⊙	■	WOOD POST
D		DEED
P		PLAT
M		MEASURED
S		SURVEYED
C		CALCULATED

I HEREBY DECLARE THAT THE ABOVE PARCEL
WAS SURVEYED DURING APRIL, 1991
PROPERTY LINES SHOWN ARE LOCATED FROM
DEEDS ON RECORD AND ARE DEED LINES.
BEARINGS ARE ASSUMED FOR ANGULAR MEA-
SUREMENT ONLY. ALL INFORMATION SHOWN IS
TRUE AND CORRECT TO THE BEST OF MY
KNOWLEDGE AND BELIEF.

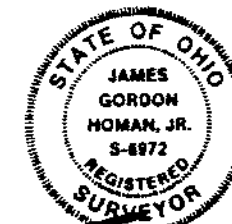

James G. Homan, Jr.
JAMES G. HOMAN, JR., P.S. #6972 DATE
ORIGINAL SIGNED IN RED INK

HANK AND ASSOCIATES, INC.

ENGINEERING • SURVEYING
137 SOUTH WASHINGTON STREET, TIFFIN, OHIO 44883
419-447-4300

SURVEY FOR: **STEVE WOLFE**

LOCATED IN THE SW. 1/4 OF SECTION 13,
PITT TOWNSHIP, T-3-S, R-14-E,
WYANDOT COUNTY, OHIO

DRAWN BY: BJN 4-08-91	CHECKED BY: JGH 4-10-91	SHEET NO. 1/1
REVISIONS		JOB NO. 91046-S (187)