



TAX MAP COPY

STATE HIGHWAY 294 60' R/W

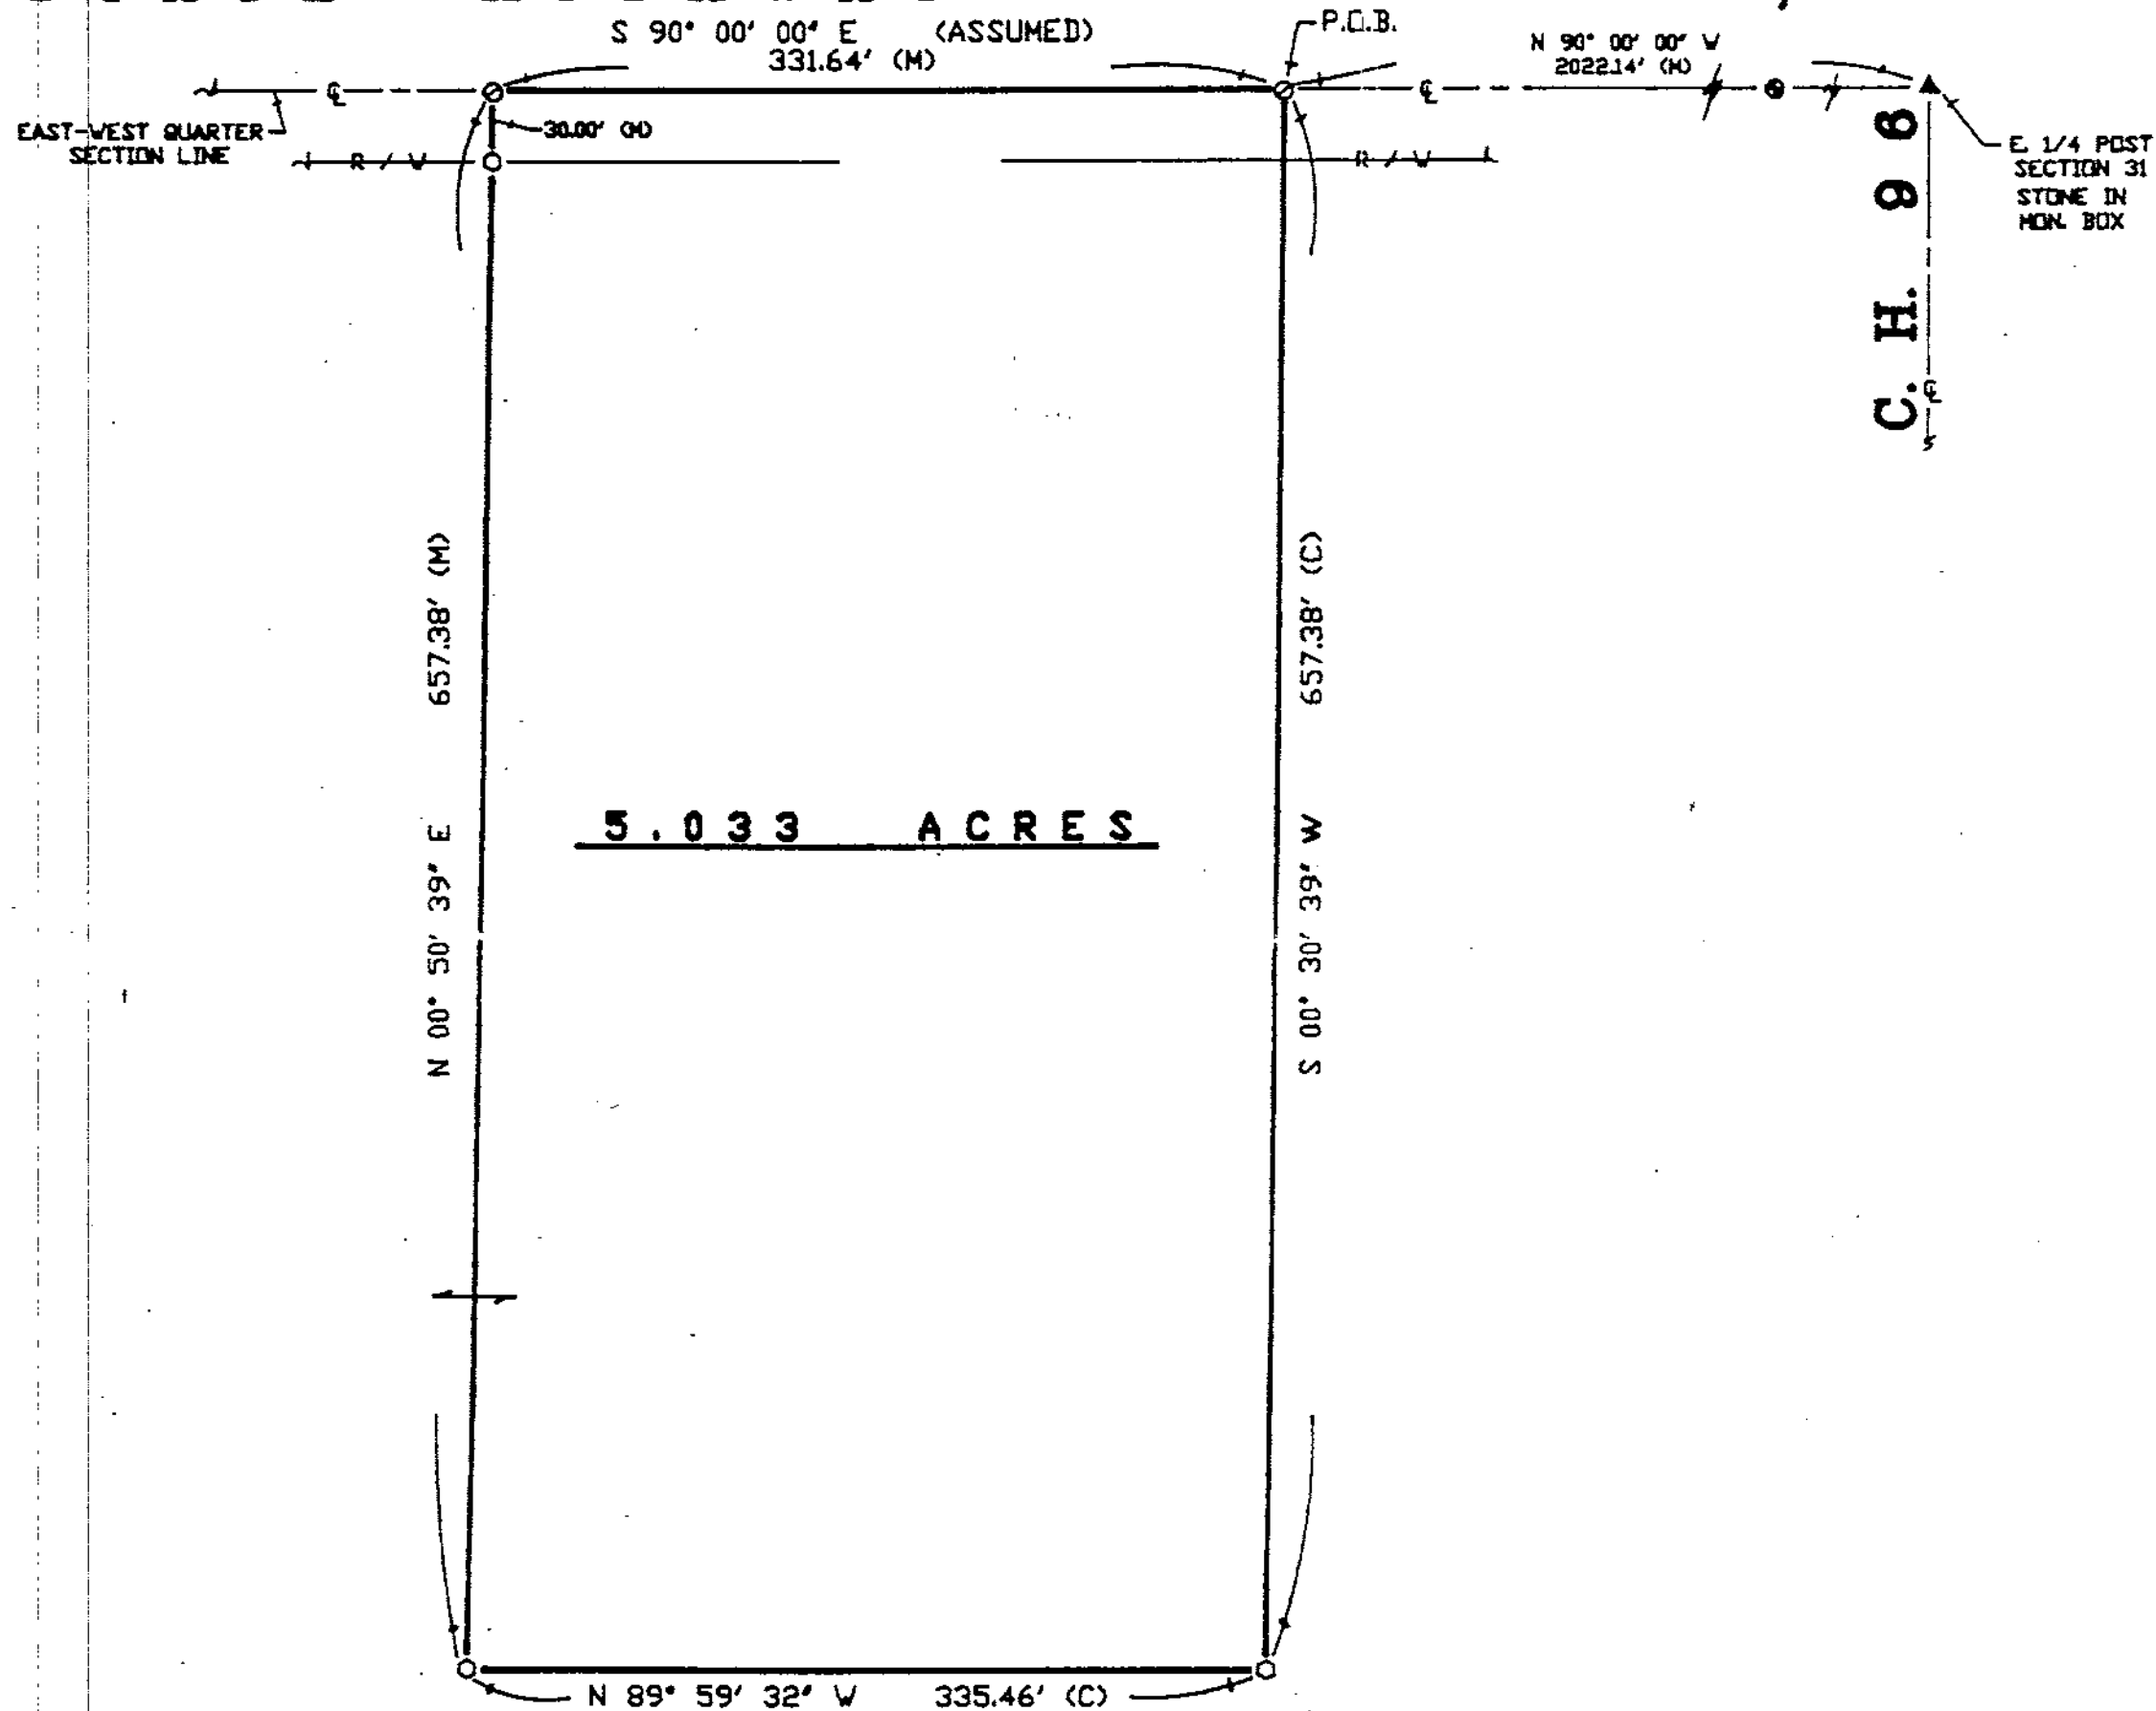

ROBERT WALTER, et ux
164 - 281

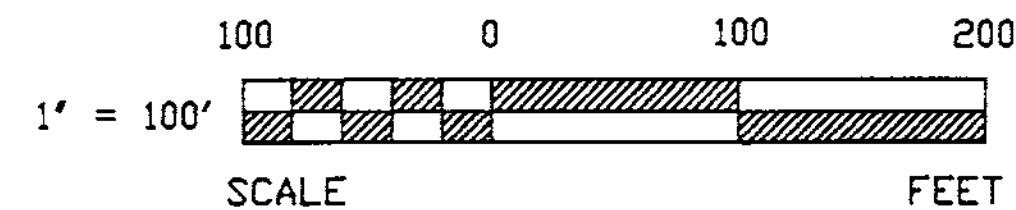

REFERENCES

DEED VOLUME & PAGE AS SHOWN
WYANDOT COUNTY CORNERSTONE REFERENCES
SURVEY NO. : #1152, #1205, & #1872

SURVEY NO. 9139
VOL 7 PAGE 173
DATE JULY 16, 1991

NOTE: ALL IRON ROD SET ARE 1/2" DIA. WITH
PERSONALIZED CAPS (HANK # 6972)
DRIVEN FLUSH.

LEGEND

SET	FOUND	DESCRIPTION
△	▲	STONE
□	■	MONUMENT BOX
⊕	⊙	CONC. MONUMENT
⊗	⊘	RAILROAD SPIKE
○	●	NAIL
○	●	IRON ROD
○	●	IRON PIPE
○	●	DRILL HOLE
○	■	WOOD POST
D		DEED
P		PLAT
M		MEASURED
S		SURVEYED
C		CALCULATED

I HEREBY DECLARE THAT THE ABOVE PARCEL
WAS SURVEYED DURING JUNE, 1991
PROPERTY LINES SHOWN ARE LOCATED FROM
DEEDS ON RECORD AND ARE DEED LINES.
BEARINGS ARE ASSUMED FOR ANGULAR MEA-
SUREMENT ONLY. ALL INFORMATION SHOWN IS
TRUE AND CORRECT TO THE BEST OF MY
KNOWLEDGE AND BELIEF.



James G. Homan, Jr.
JAMES G. HOMAN, JR., P.S. #6972 DATE
ORIGINAL SIGNED IN RED INK

HANK AND ASSOCIATES, INC.

ENGINEERING • SURVEYING
137 SOUTH WASHINGTON STREET, TIFFIN, OHIO 44883
419-447-4300

SURVEY FOR: **ROBERT WALTER**

LOCATED IN THE SE. 1/4 OF SECTION 31,
MIFFLIN TOWNSHIP, T-3-S, R-13-E,
WYANDOT COUNTY, OHIO

DRAWN BY: CHECKED BY: SHEET NO.

DJN 6-91 JGH 07-01-91 1/1

REVISIONS JOB NO.

91074-S
(299)