




1' = 50'  
SCALE FEET

MICHAEL SCHENKBERGER  
189 - 395

KALMBACH FEEDS, INC.  
192 - 906

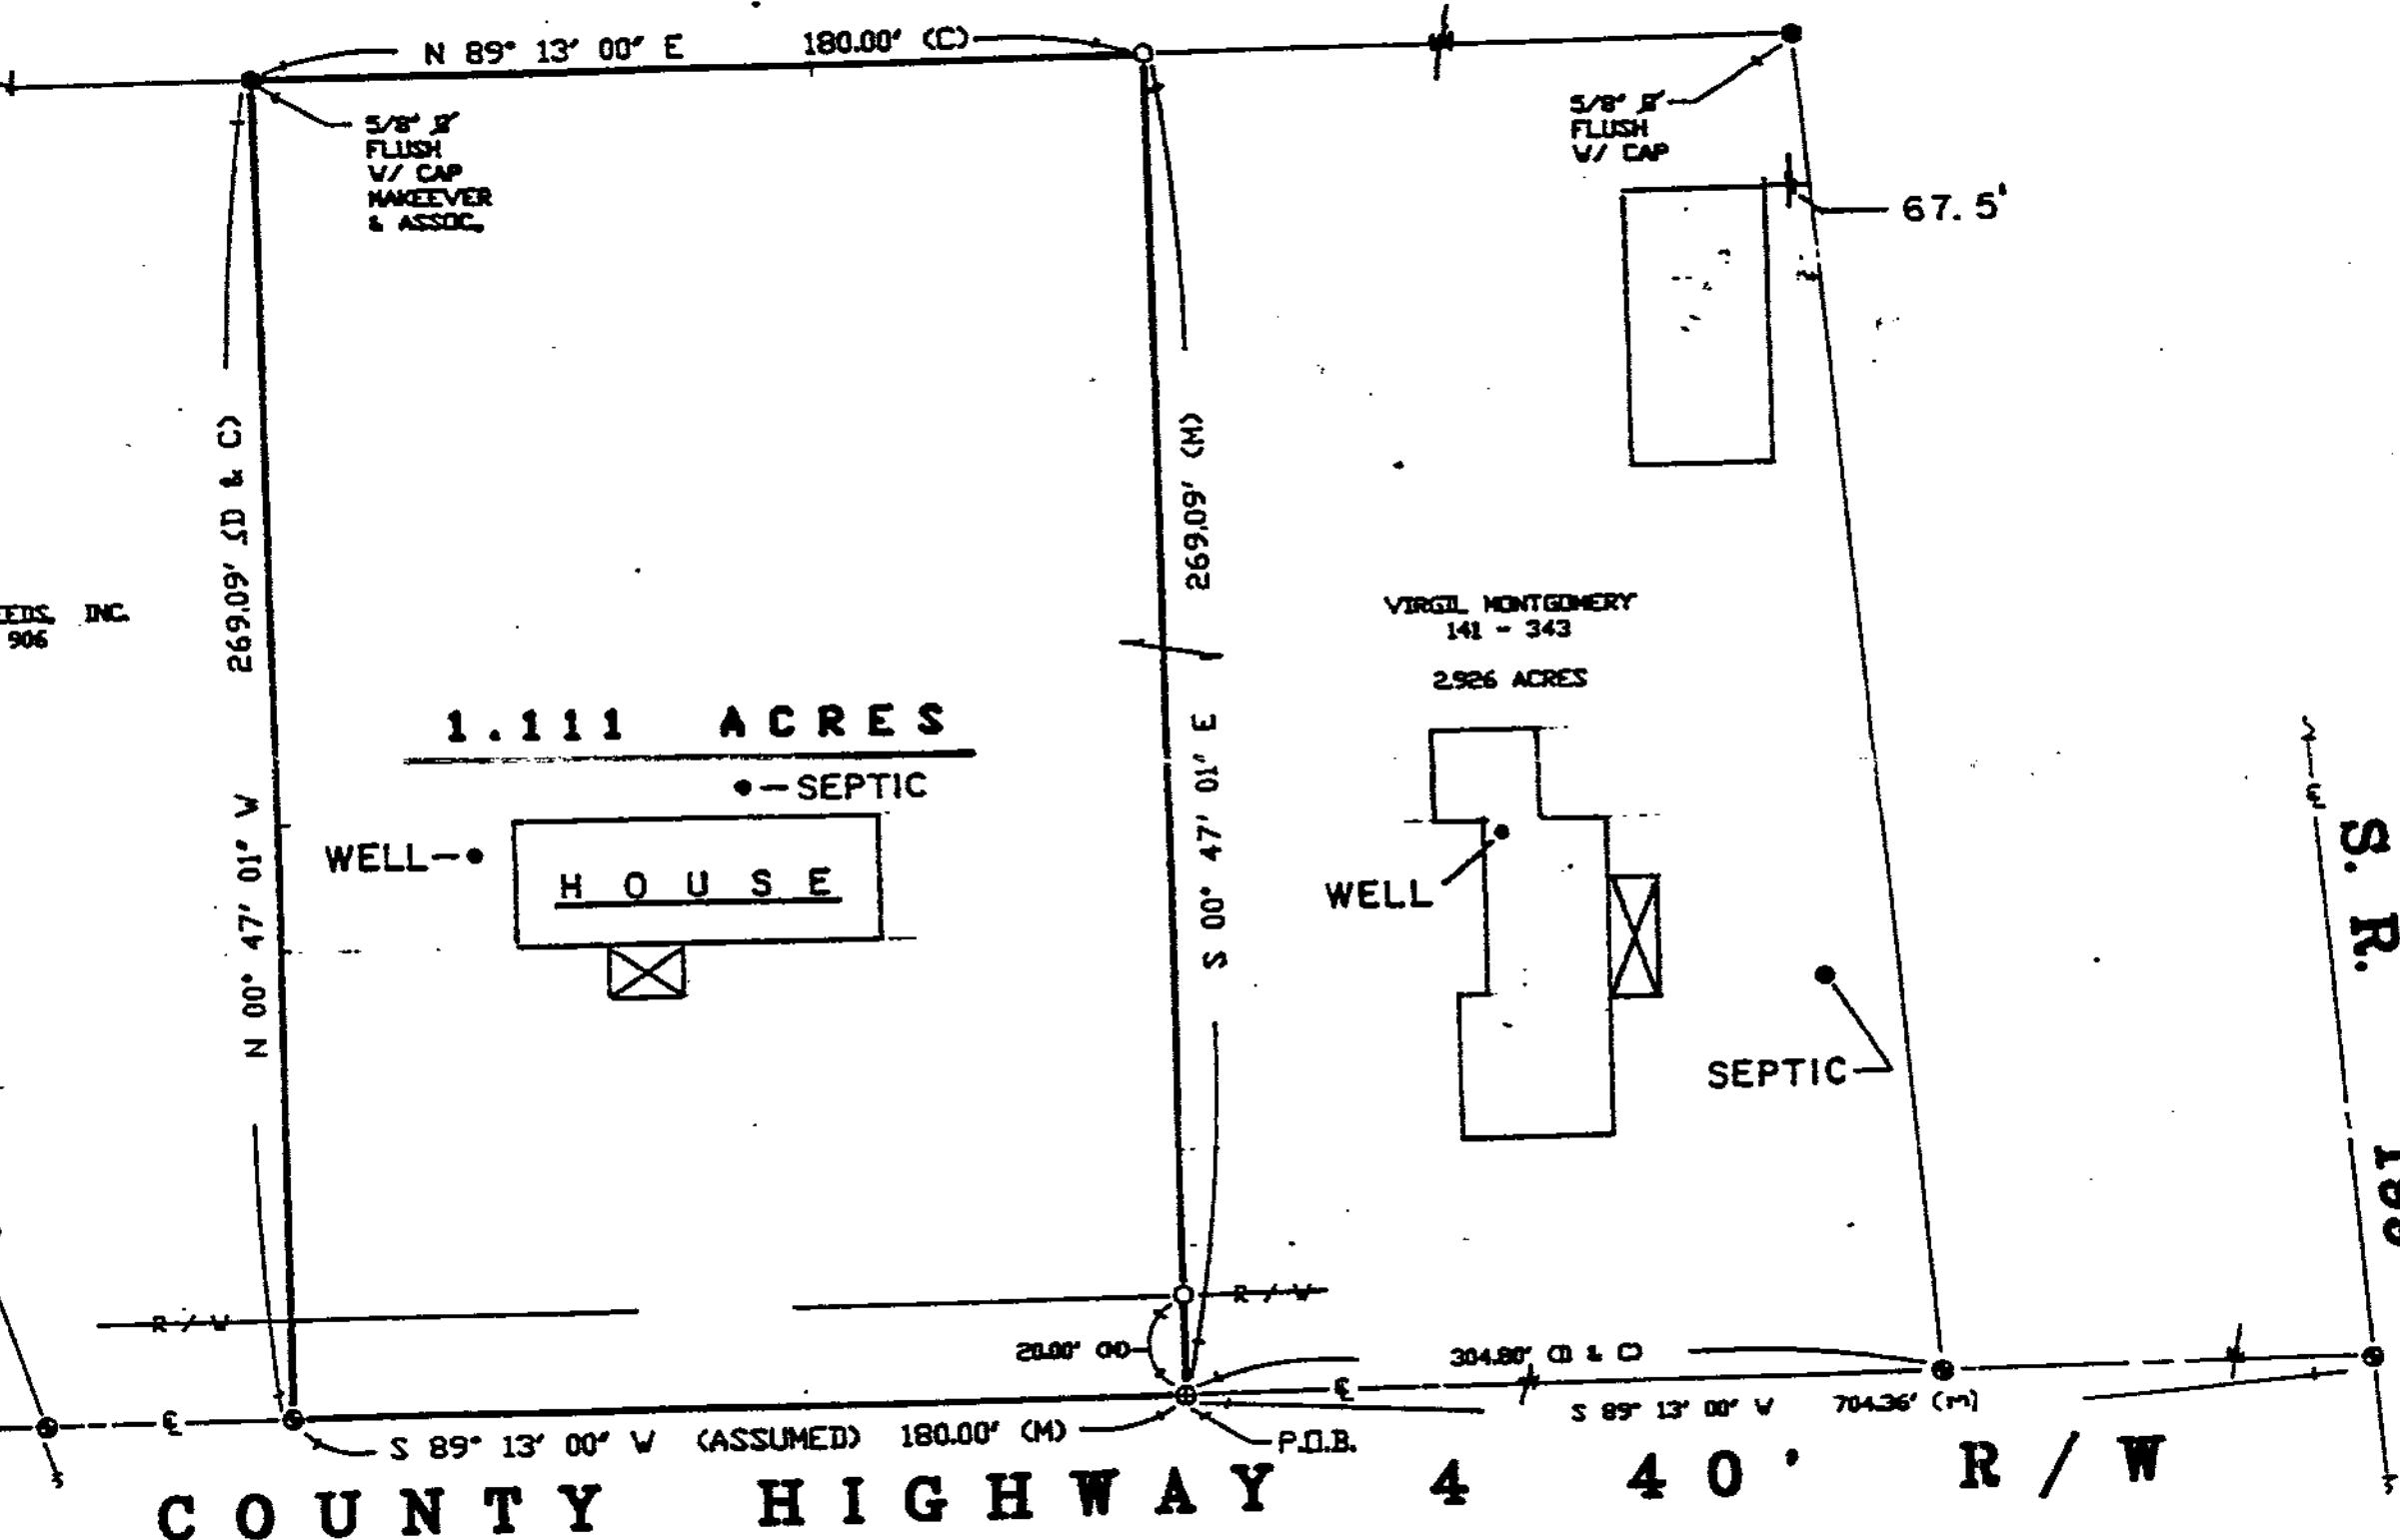

REFERENCES

DEED VOLUME & PAGE AS SHOWN

SURVEY VOLUME 6, PAGE 551

SURVEY NO. 9160

VOL 7 PAGE 194

DATE 9-30-91

NOTE: ALL IRON ROD SET ARE 1/2" DIA. WITH  
PERSONALIZED CAPS (HANK #6972)  
DRIVEN FLUSH.

I HEREBY DECLARE THAT THE ABOVE PARCEL  
WAS SURVEYED DURING SEPT., 1991.  
PROPERTY LINES SHOWN ARE LOCATED FROM  
DEEDS ON RECORD AND ARE DEED LINES.  
BEARINGS ARE ASSUMED FOR ANGULAR MEA-  
SUREMENT ONLY. ALL INFORMATION SHOWN IS  
TRUE AND CORRECT TO THE BEST OF MY  
KNOWLEDGE AND BELIEF.

LEGEND		
SET	FOUND	DESCRIPTION
△	▲	STONE
□	□	MONUMENT BOX
○	○	CONC. MONUMENT
⊕	⊕	RAILROAD SPIKE
●	●	NAIL
■	■	IRON ROD
○	○	IRON PIPE
○	○	DRILL HOLE
○	○	WOOD POST
D	▲	DEED
P	○	PLAT
M	⊕	MEASURED
S	●	SURVEYED
C	■	CALCULATED

STATE OF OHIO  
JAMES GORDON HOMAN, JR.  
#6972  
REGISTERED SURVEYOR  
James G. Homan, Jr., P.S. #6972 DATE  
ORIGINAL SIGNED IN RED INK

HANK AND ASSOCIATES, INC.

ENGINEERING • SURVEYING  
137 SOUTH WASHINGTON STREET, TIFFIN, OHIO 44883  
419-447-4300

SURVEY FOR: KEITH MONTGOMERY

LOCATED IN THE NW. 1/4 OF SECTION 2,  
SALEM TOWNSHIP, T-2-S, R-13-E,  
WYANDOT COUNTY, OHIO

DRAWN BY:	CHECKED BY:	SHEET NO.
JUN 9-91	JGH	1 1
REVISIONS		JOB NO.
CHANGED RIM @ NE CORNER - 704.36' To 691		91117-S (495)