


REFERENCES

O DEED VOLUME & PAGE AS SHOWN.
O WYANDOT COUNTY CORNERSTONE RECORDS.

LEGEND


SET	FOUND	DESCRIPTION
●	●	MONUMENT
●	●	RAILROAD SPIKE
●	●	NAIL
●	●	IRON PIPE
●	●	DRILL HOLE
●	●	5/8" Ø IRON ROD WTH PERSONALIZED CAP
●	●	IRON ROD
■	■	FENCE POST
▲	▲	STONE
□	□	MONUMENT BOX
☒	☒	CONCRETE MONUMENT
X-X	X-X	FENCE
D	D	DEED
P	P	PLAT
M	M	MEASURED
C	C	CALCULATED
Ø	Ø	DIAMETER
SR	SR	SURVEY RECORD
E/P	E/P	EDGE OF PAVEMENT
R/W	R/W	RIGHT OF WAY
L.A. R/W	L.A. R/W	LIMITED ACCESS R/W
⊗	⊗	CONCRETE RIGHT OF WAY MARKER
P/L	P/L	PROPERTY LINE
□	□	HOUSE
□	□	GARAGE
□	□	BARN
□	□	SHED
~~~~~	~~~~~	WATERWAY/TILE
~~~~~	~~~~~	SURFACE DRAINAGE
R.P. R/W	R.P. R/W	REGIONAL PLANNING REQUIRED R/W

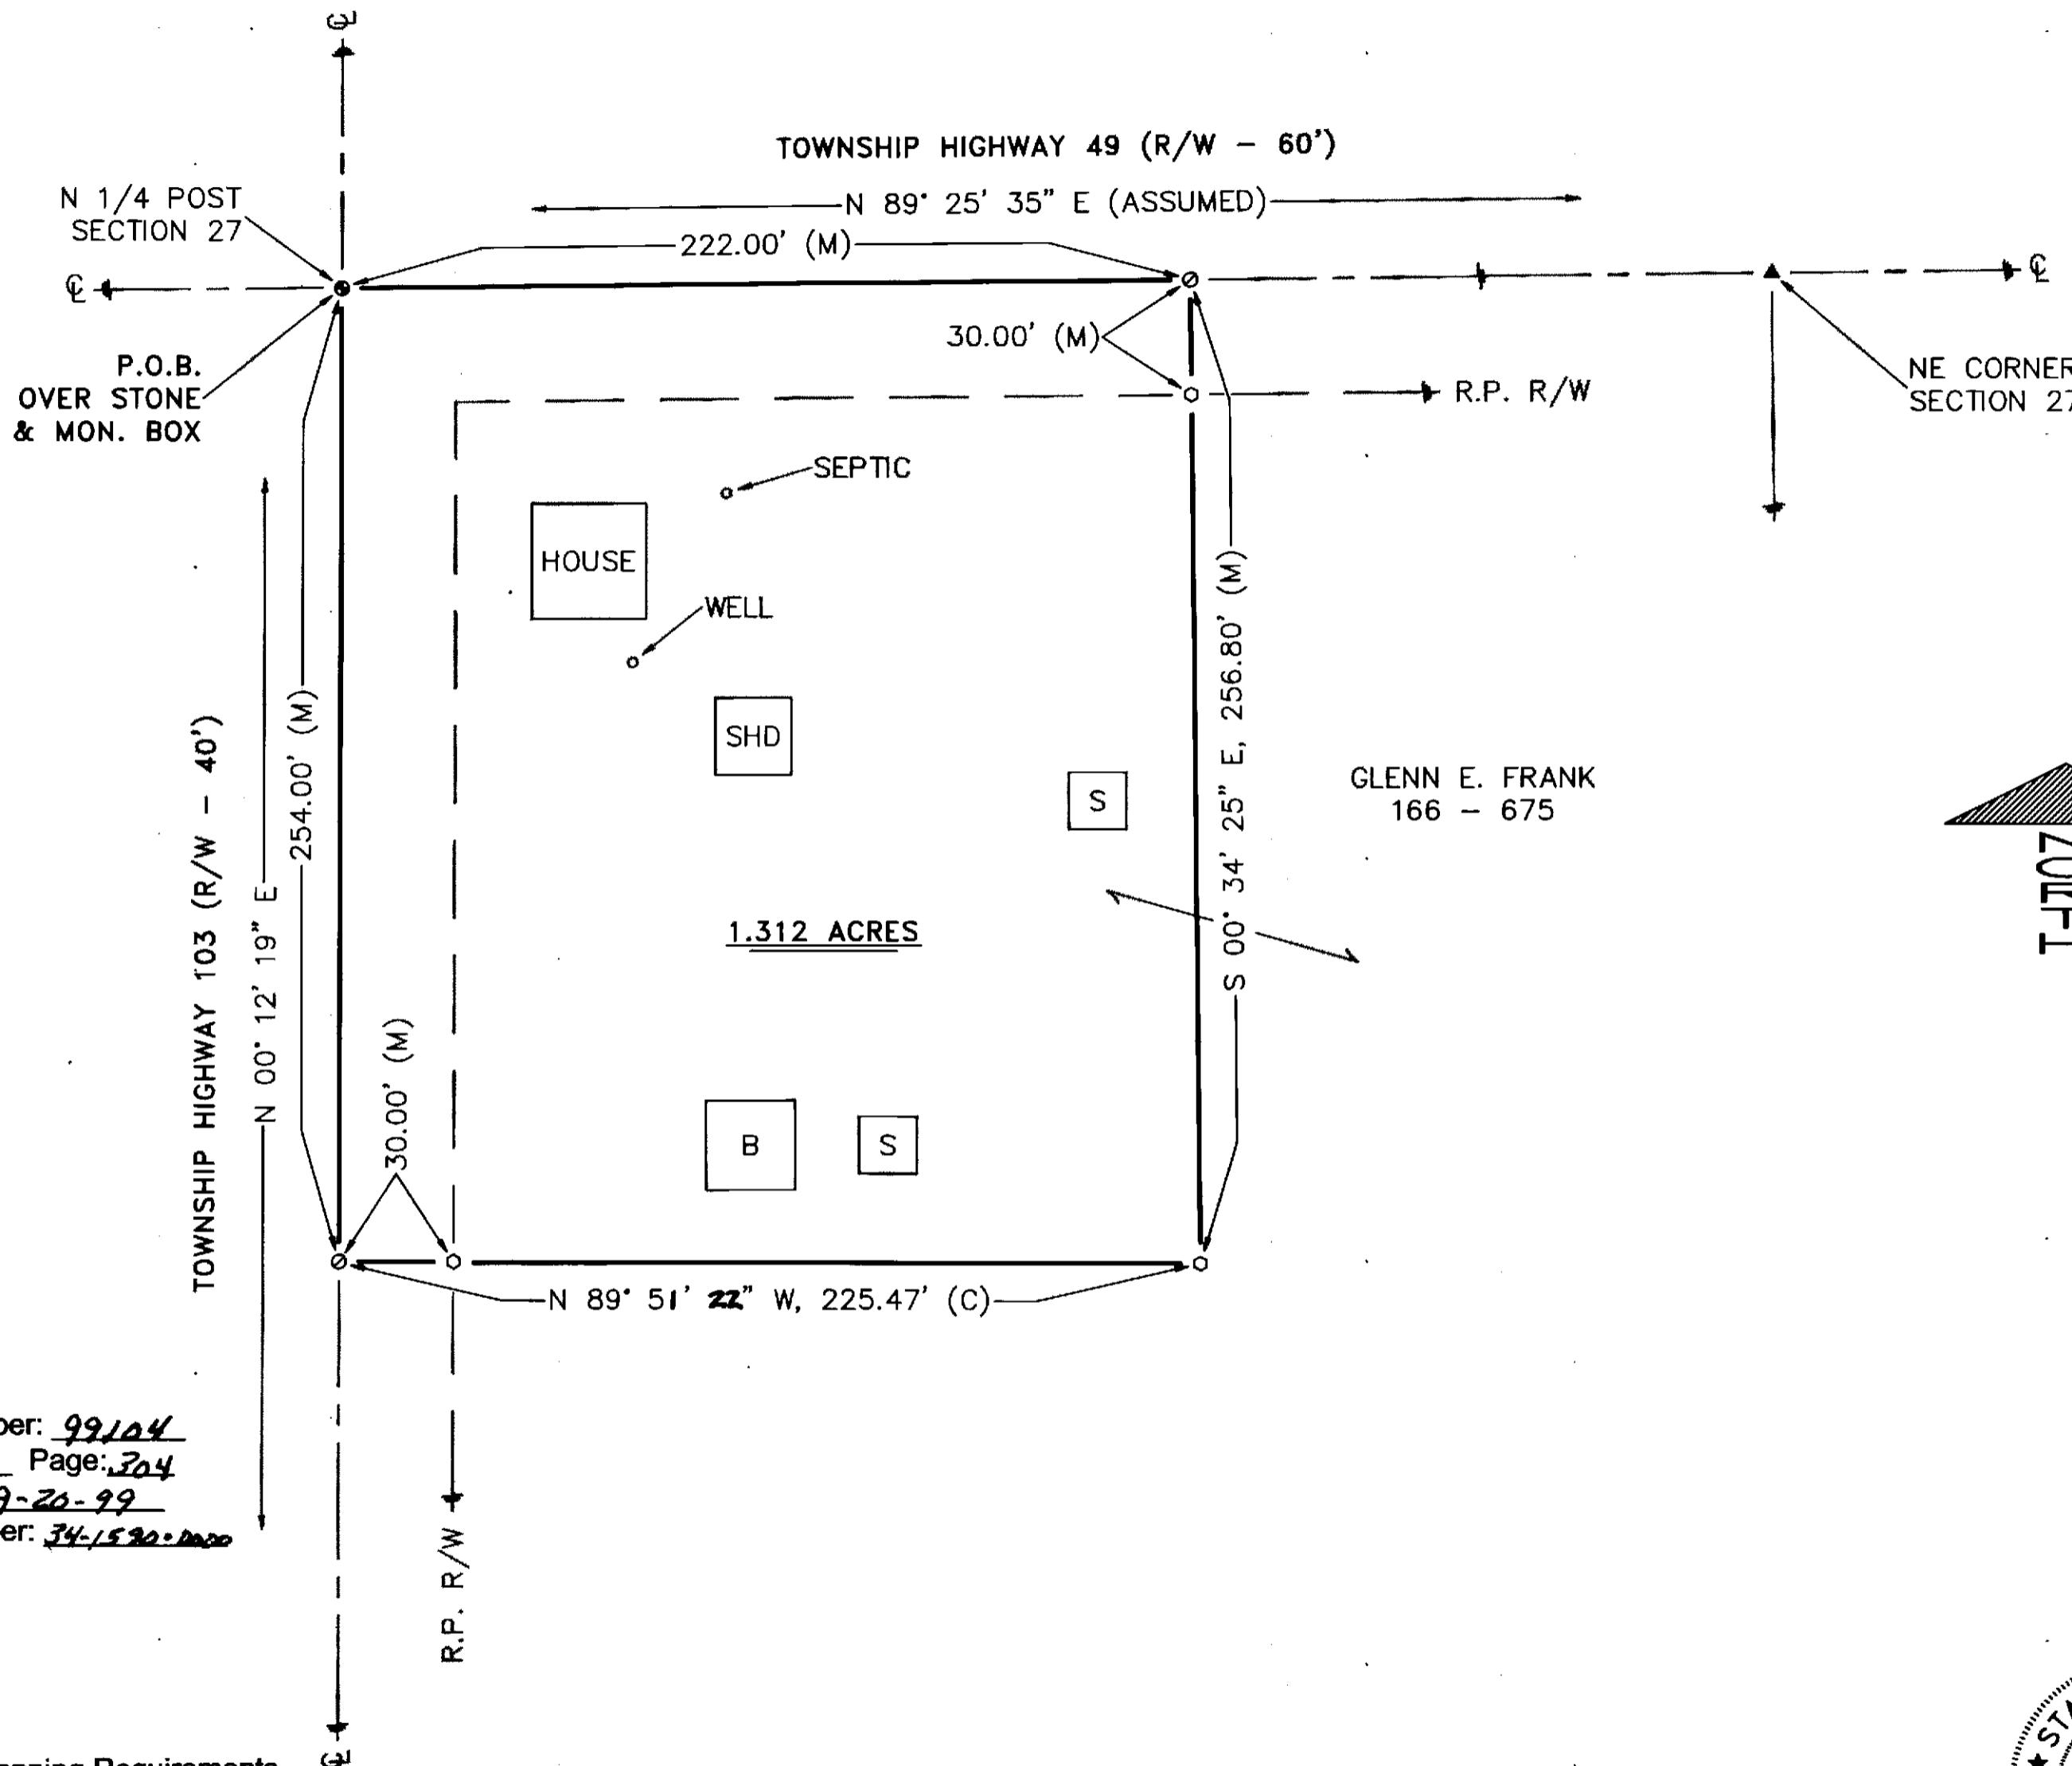

Survey Number: 99104
Volume: C Page: 204
Date Filed: 9-20-99
Parcel Number: 34-520-000

All Regional Planning Requirements have been approved for this survey
Application # 99-90

NOTE: THIS SURVEY DOES NOT INCLUDE A TITLE SEARCH.
EASEMENTS OR OTHER ENCUMBERANCES ON OR
OVER THE LAND ARE NOT SHOWN ON THIS SURVEY.
BUILDINGS AND OTHER STRUCTURES ARE NOT TO SCALE.
I HEREBY DECLARE THAT I HAVE SURVEYED THE ABOVE
DESCRIBED PROPERTY DURING AUGUST 1999.
THIS SURVEY IS SUBJECT TO ALL LEGAL HIGHWAYS,
EASEMENTS, RESTRICTIONS, LEASES OF RECORD
AND OF RECORDS IN RESPECTIVE UTILITY OFFICES.
THE BEARINGS REFERRED TO HEREON ARE BASED
ON AN ASSUMED MERIDIAN AND ARE ONLY FOR
THE PURPOSE OF ANGULAR MEASUREMENT.

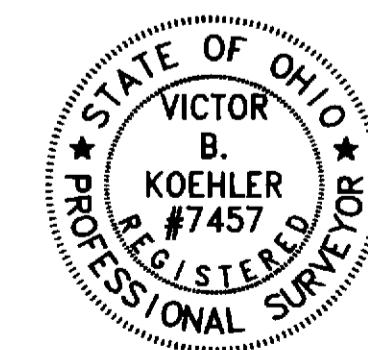

VICTOR B. KOEHLER, P.S. NO. 7457

09-10-99

DATE

S-49104	DRAWN BY	CHECKED BY	REVISION
T / I	FRS 08-04-99	VBK 08-06-99	

SURVEY FOR: VERNON KOEHLER
LOCATED IN PART OF THE NORTHEAST
QUARTER OF SECTION 27, T-2-S, R-13-E,
SALEM TOWNSHIP, WYANDOT COUNTY, OHIO.

KOEHLER SURVEYING
P.O. BOX 28
UPPER SANDUSKY, OHIO 43351
419-294-5388