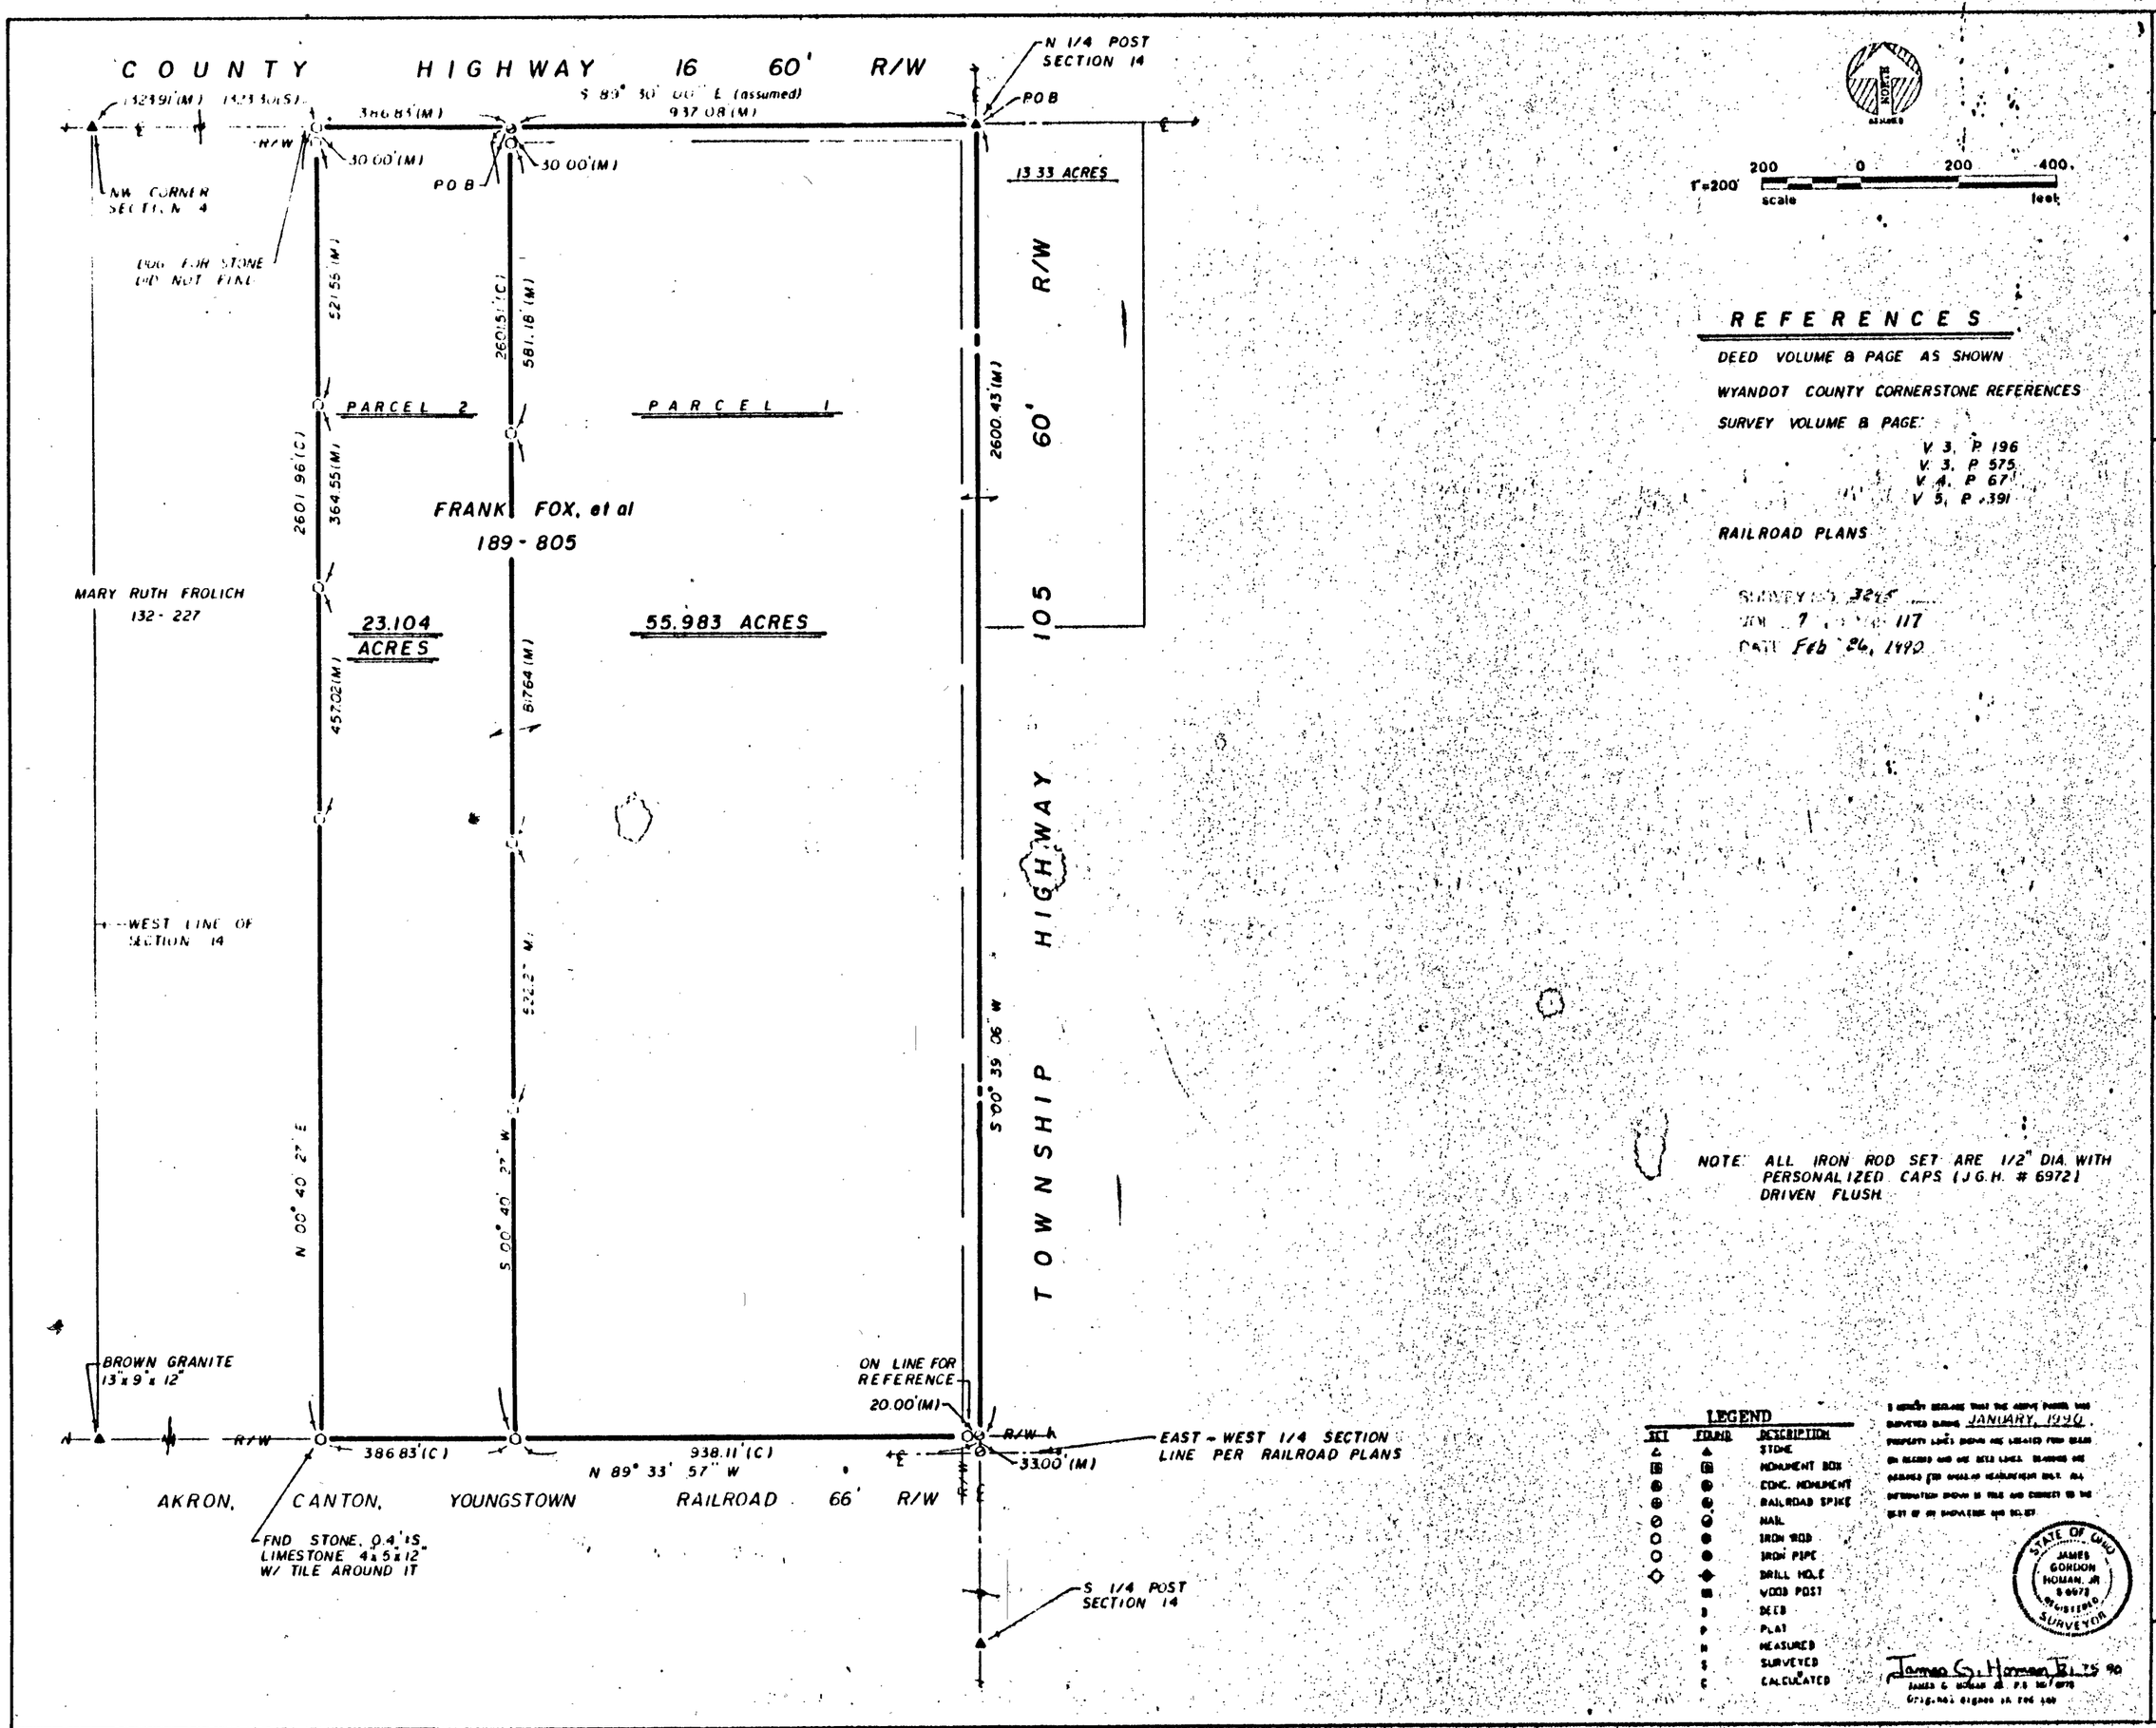
COUNTY HIGHWAY 16 60' R/W
N 1/4 POST SECTION 14
POB
S 89° 30' 00" E (assumed)
937.08 (M)
30.00' (M)
30.00' (M)
POB
NW CORNER SECTION 4
FND FOR STONE DID NOT FIND
13.33 ACRES
R/W
60'
105
TOWNSHIP HIGHWAY
2600.43' (M)
581.16' (M)
2601.5' (C)
521.55' (M)
PARCEL 2
PARCEL 1
FRANK FOX, et al
189 - 805
2601.96' (C)
364.55' (M)
MARY RUTH FROLICH
132 - 227
23.104 ACRES
55.983 ACRES
457.02' (M)
617.64' (M)
WEST LINE OF SECTION 14
N 00° 40' 27" E
S 00° 40' 27" W
522.27' M
S 00° 35' 06" W
BROWN GRANITE 13"x 9"x 12"
ON LINE FOR REFERENCE
20.00' (M)
R/W
386.83' (C)
938.11' (C)
N 89° 33' 57" W
33.00' (M)
EAST - WEST 1/4 SECTION LINE PER RAILROAD PLANS
AKRON, CANTON, YOUNGSTOWN RAILROAD 66' R/W
FND STONE, 0.4' IS LIMESTONE 4"x 5"x 12" W/ TILE AROUND IT
S 1/4 POST SECTION 14
NORTH
1"=200'
200 0 200 400
scale feet
REFERENCES
DEED VOLUME 8 PAGE AS SHOWN
WYANDOT COUNTY CORNERSTONE REFERENCES
SURVEY VOLUME 8 PAGE:
V. 3, P. 196
V. 3, P. 575
V. 4, P. 67
V. 5, P. 391
RAILROAD PLANS
SURVEY NO. 3245
DATE Feb 26, 1990
NOTE: ALL IRON ROD SET ARE 1/2" DIA. WITH PERSONALIZED CAPS (J.G.H. # 6972) DRIVEN FLUSH.
LEGEND
SET FOUND DESCRIPTION
STONE
MONUMENT BOX
CONC. MONUMENT
RAILROAD SPIKE
NAIL
IRON ROD
IRON PIPE
DRILL HOLE
WOOD POST
DEED
PLAT
MEASURED
SURVEYED
CALCULATED
I HEREBY DECLARE THAT THE ABOVE PLAT WAS SURVEYED DURING JANUARY, 1990.
PROPERTY LINES SHOWN ARE LOCATED FROM DEED OR RECORD AND ARE NOT SURVEY LINES. BEARINGS ARE BASED FOR ANGLE OR MEASUREMENT ONLY. ALL INFORMATION SHOWN IS TRUE AND CORRECT TO THE BEST OF MY KNOWLEDGE AND BELIEF.
STATE OF OHIO JAMES GORDON HOMAN, JR. 6972 REGISTERED SURVEYOR
James G. Homan Jr. 2-26-90
JAMES G. HOMAN JR. P.S. NO. 6972
Original signed in red ink
SHEET NO. 1/1
REVISIONS
CHECKED BY: JGH 1-25-90
DRAWN BY: djp 1-11-90
PLAT FOR FRANK FOX
LOCATED IN THE NW 1/4 OF SECTION 14, CRAWFORD TOWNSHIP T-1-S, R-13-E, WYANDOT COUNTY, OHIO
HANK AND ASSOCIATES, INC.
ENGINEERING • SURVEYING
49 SOUTH WASHINGTON STREET, TIFFIN, OHIO 44883
419-447-4300
JOB NO. 89116-S (351)